


T. 35 S., R. 1 W., W. M.

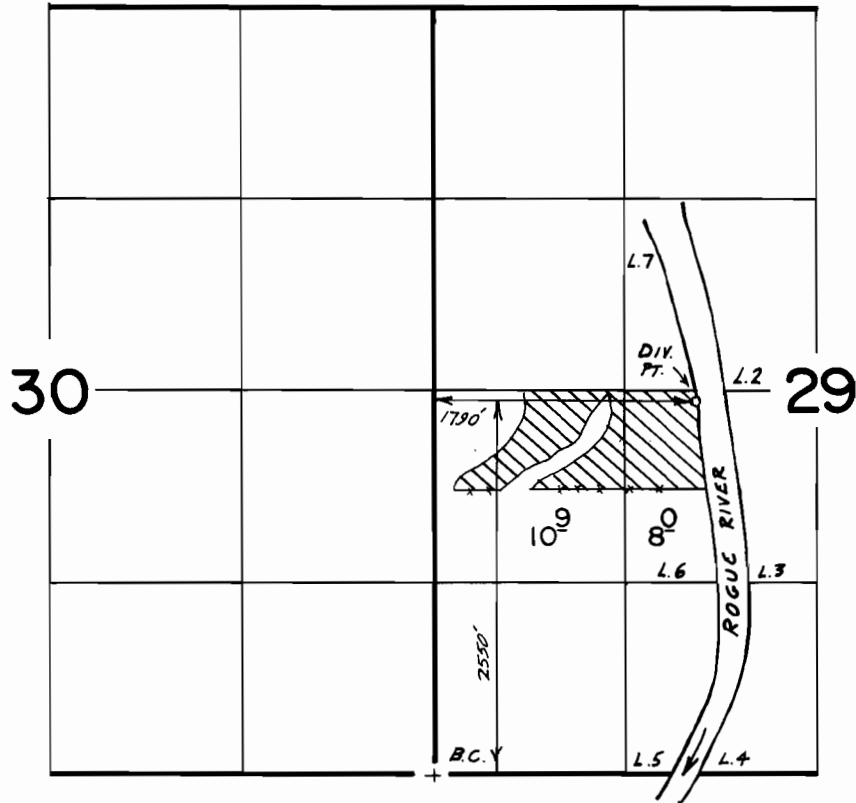

Scale 1"=1320'

FINAL PROOF SURVEY
UNDER

Application No. 60995... Permit No. 45659.....
IN NAME OF

...JOHN & PENNY D. ESSER.....

Surveyed Nov. 19... 1985, by B.S. JAMES.....