


T. 38 S., R. 3 W., W. M.

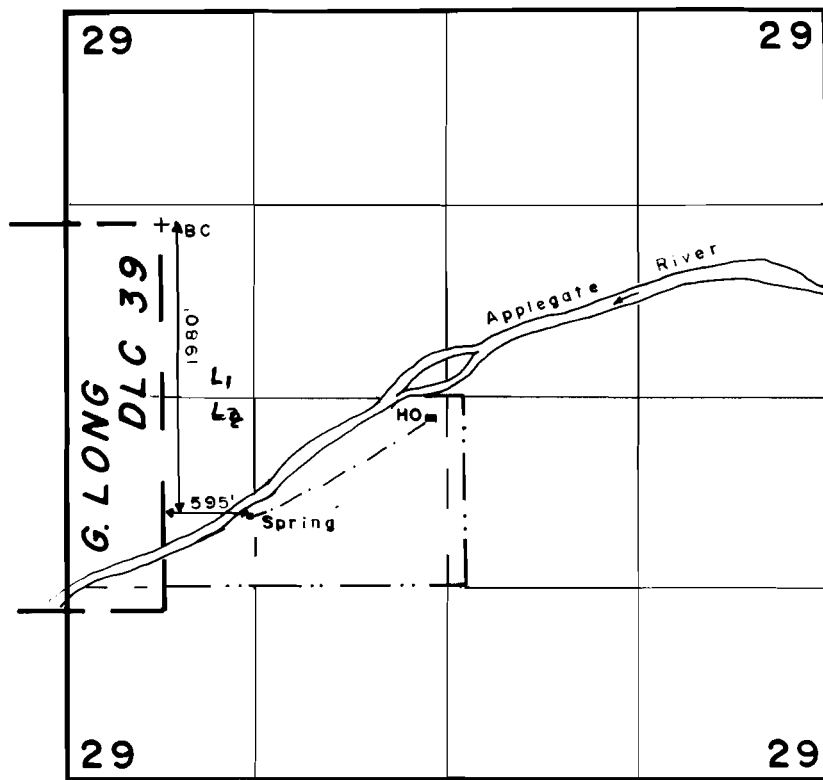

SCALE: 4" = 1 MILE

FINAL PROOF SURVEY
UNDER

Application No. **61503** Permit No. **45726**
IN NAME OF

NORMAN F. & MARGO E. HOMEIR

Surveyed **JUNE 12 1985**, by **B. S. JAMES**