



T. 38S., R. 3W., W.M.

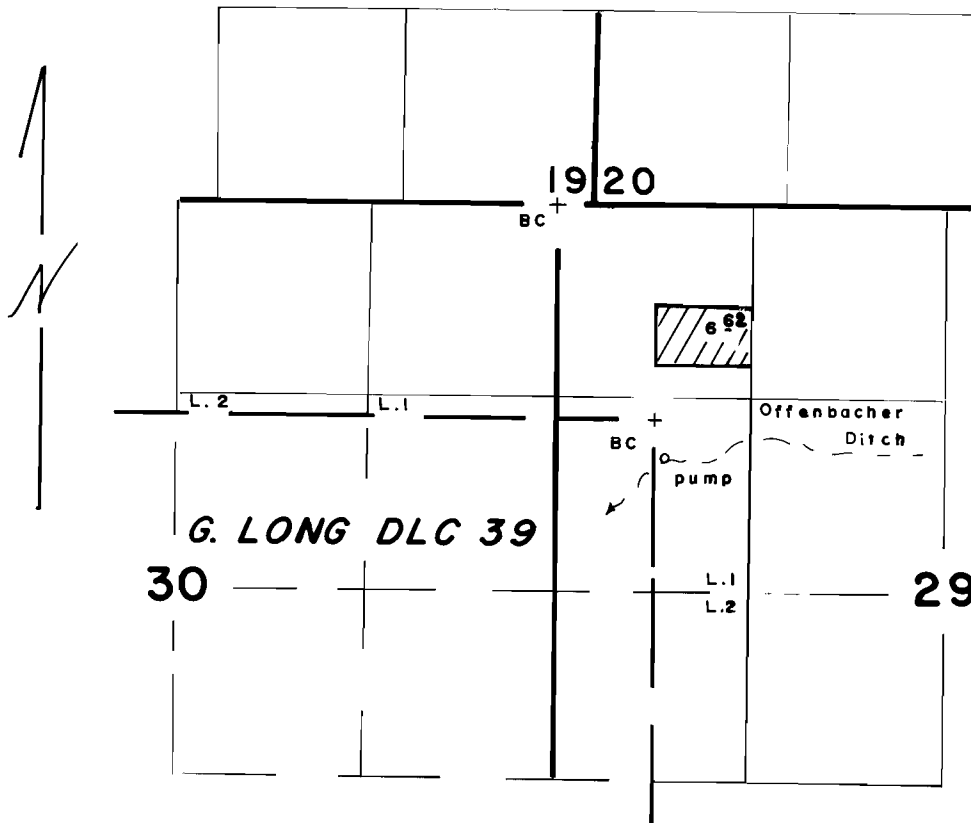

G. LONG DLC 39

SCALE: 4" = 1 MILE

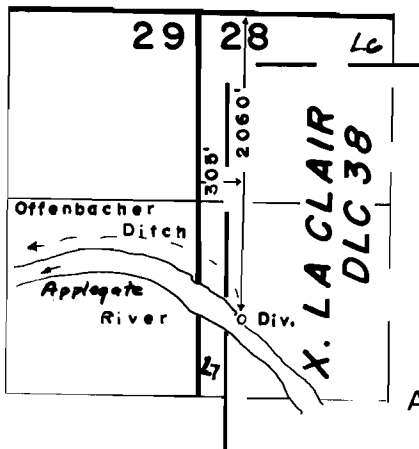

FINAL PROOF SURVEY
UNDER

Application No. 62213 Permit No. 46081...
IN NAME OF

WILEY M. BURNETT

Surveyed JUNE 13, 1985, by B. S. JAMES...