


T.35S. R.6W. W.M.

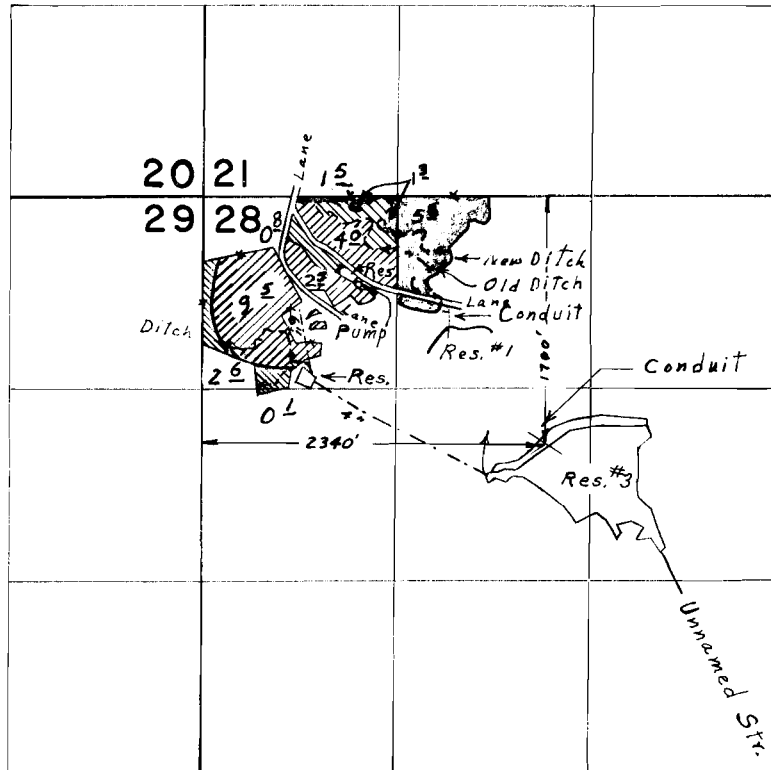

 PRIMARY
 SUPPLEMENTAL } PERMIT 29349

FINAL PROOF SURVEY

UNDER

R-43931

R-5062

43932

32855

R-39284

R-3945

Application No. 39285 Permit No. 29349

IN NAME OF

DR. SAMUEL WERNER

Surveyed April 22 1974, by L. E. Gould

Inspection September 28, 1982 by S. James E.T.1