


RECEIVED

DEC 22 1981

WATER AND UTILITIES DEPT
SEASIDE, OREGON

T. 37 S., R. 6 W., W.M.

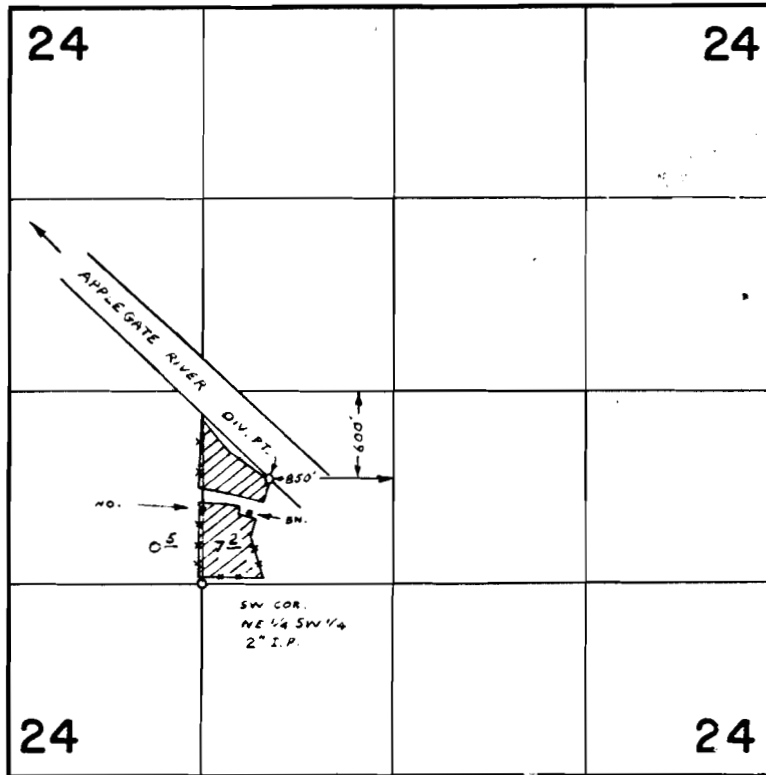

Application No. 62344

Permit No. 46492

~~FINAL PROOF SURVEY~~
UNDER

Application No. 52617 Permit No. 39669
IN NAME OF

MICHAEL W. & NANCY I. MEER

Surveyed OCT. 3 1978, by B. SUND