


T. 21 S., R. 2 & 3 W., WM.

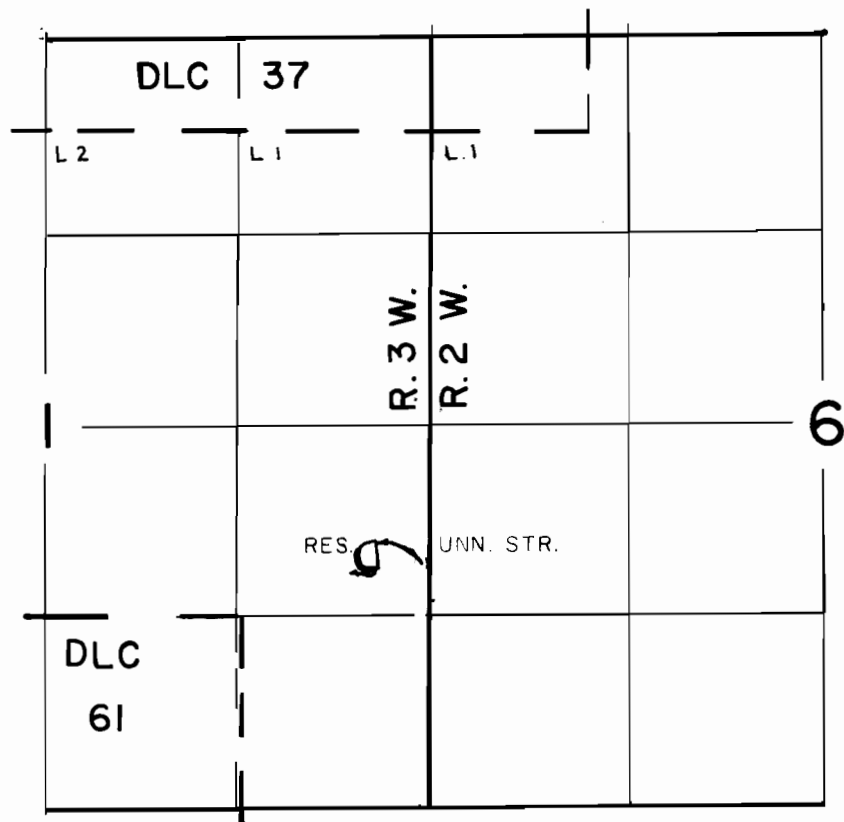

DIV. PT. LOC. 1820' N & 350' W. OF SE COR. SEC 1

FINAL PROOF SURVEY UNDER

R 56119

R 6627

Application No. 56120 Permit No. 41953

IN NAME OF

MRS. POLLY HATCH MOSBY

Surveyed SEP. 26 19.84, by P. PAGTER