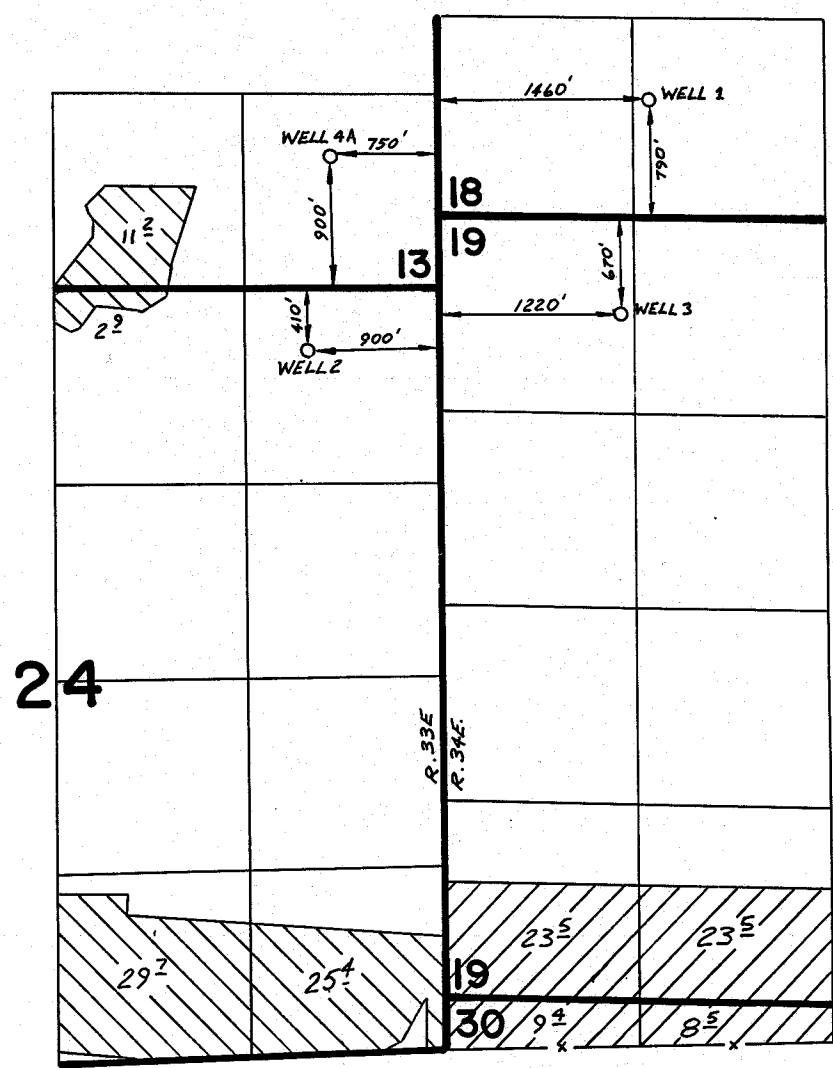

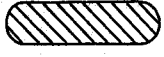


T. 6N. R. 33 & 34E. W.M.



WELLS 1 & 3 
 WELLS 2 & 4A 

FINAL PROOF SURVEY UNDER

Application No. G-6521 Permit No. G-6366
 IN NAME OF

JOHN L. GEYER

Surveyed 1-17 1979, by K. BARWIN