


T. 37 S. R. 5 W. W.M.

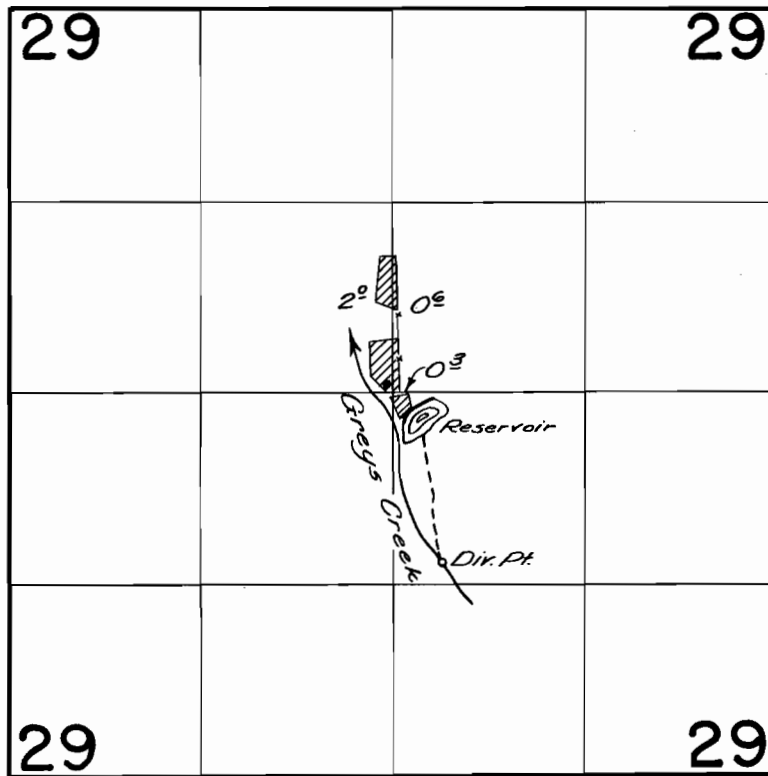

**FINAL PROOF SURVEY**  
UNDER

Application No. <sup>R-31834</sup> ~~31835~~ Permit No. <sup>R-2070</sup> ~~25102~~  
IN NAME OF

.....H. R. TOBIASON.....

Surveyed April 12, 1961, by C. C. Bartlett