


T.12S.,R.36E.,W.M.

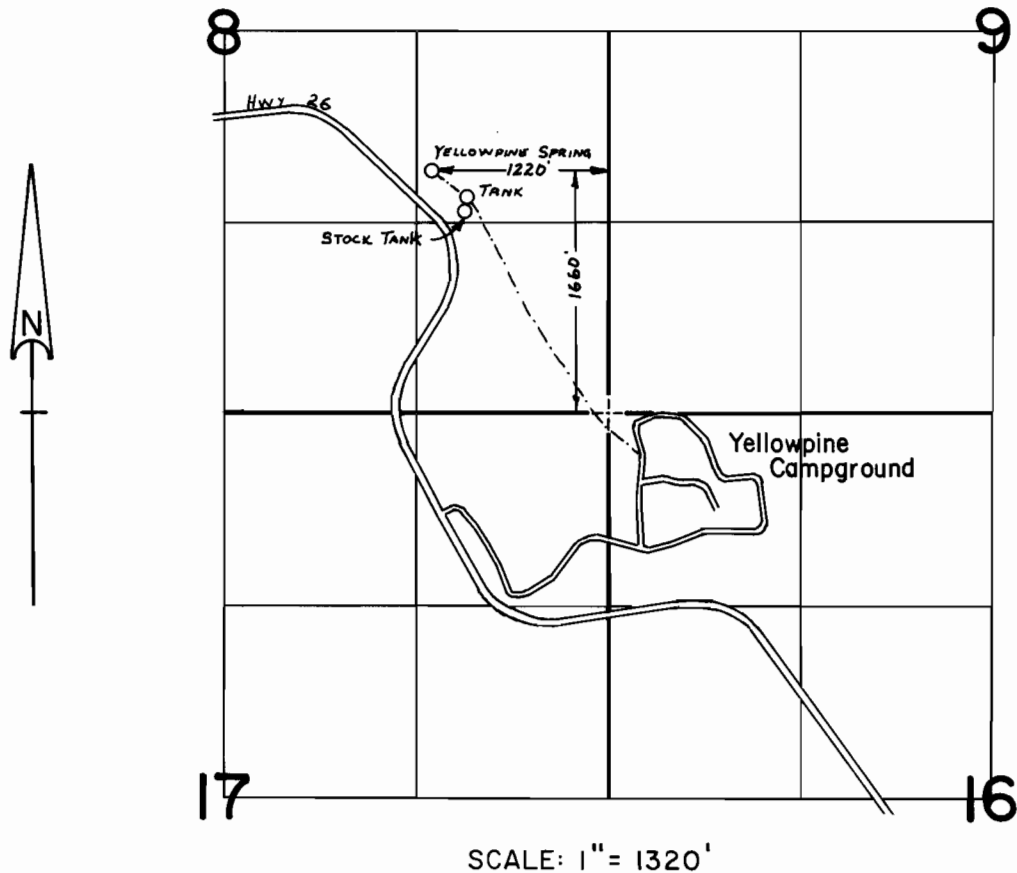

FINAL PROOF SURVEY
UNDER

Application No. ..61312.. Permit No. ..46792.....
IN NAME OF

U. S.,..WALLOWA-WHITMAN..NAT.....FOR.

Surveyed ..Oct.....1.... 19.85, by ..L..M..TOLL.....