


T.6S.,R.46E.,W.M.

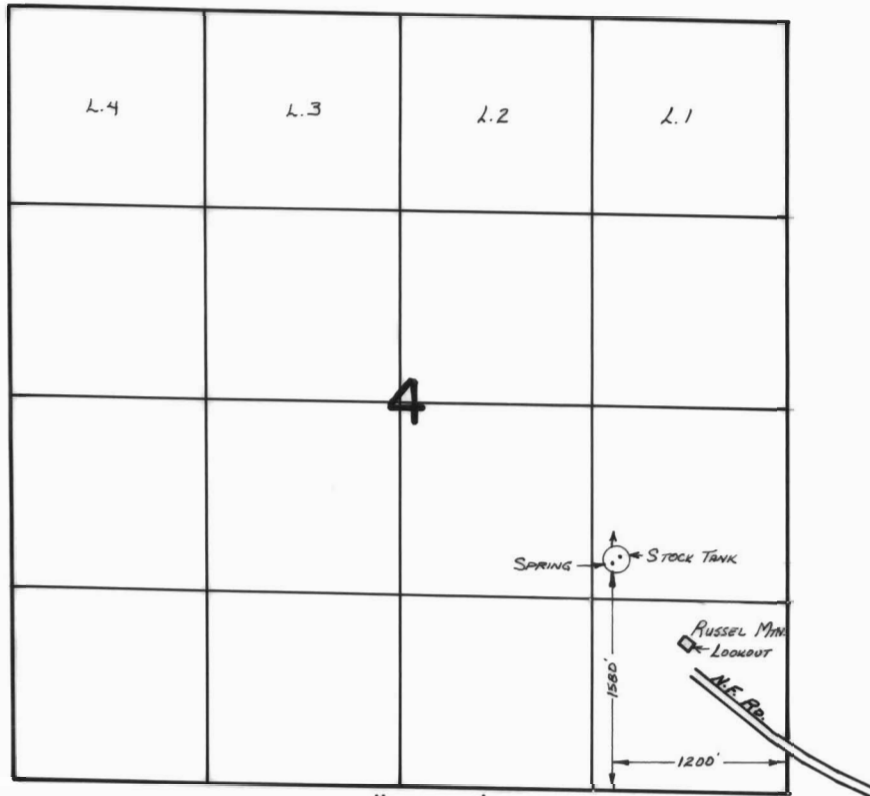

SCALE: 1"=1320'

FINAL PROOF SURVEY
UNDER

Application No. 60769.. Permit No. 47754.....
IN NAME OF

WALLOWA-WHITMAN NATIONAL FOREST

Surveyed Aug....7.... 19.85., by L.M.TOLL.....