


FINAL PROOF SURVEY
UNDER
APPL. 48589 PER. 36528
IN NAME OF
MITCHELL, JOHN R. & HALE, EVAN N.
SURVEYED 6-5-80 BY V. CHURCH



Map edited and published by the Geological Survey
Control by USGS and NOS/NOAA
Topography by photogrammetric methods from aerial
photographs taken 1971. Field checked 1972
Projection, north zone (Lambert conformal conic)
100,000-foot grid ticks
100,000-foot grid ticks
Zone 11, shown in blue. 1927 North American datum
Fine red dashed lines indicate selected fence lines

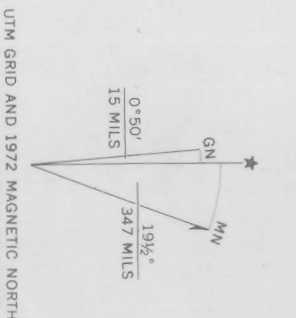

SCALE 1:24,000
2373 II SW
CONTAINING INTERVAL 40 FEET
NATIONAL GEODETIC DATUM OF 1929
1 MILE
1 KILOMETER

ROAD CLASSIFICATION
Primary highway
Light-duty road, hard or
hard surface
Secondary highway
Unimproved road
Interstate Route
U S Route
State Route

SUMPTER, OREG.
WATERMASTER DISTRICT #8
BAKER COUNTY COURT HOUSE
BAKER, OREGON 97814

AMS 2373 II NW-SERIES V882