
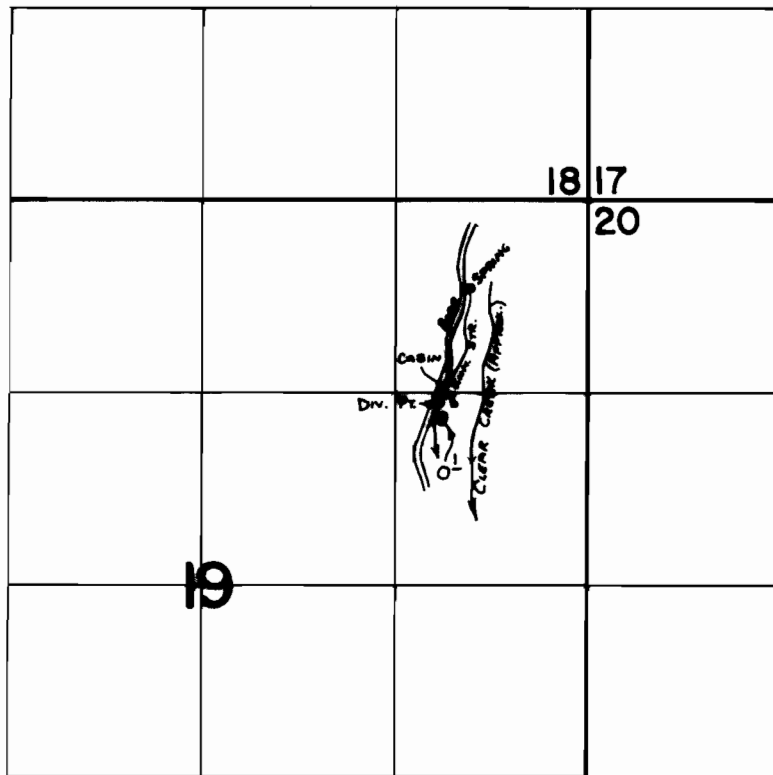


T.7S.,R.46E.,W.M.

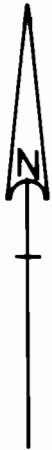

DIV. PT. - 1400 ft. S and 1020 ft. W from NE Cor. Sec. 19

SCALE: 1" = 1320'

FINAL PROOF SURVEY
UNDER

Application No. ...55632. Permit No. ...41681.....
IN NAME OF

.....GREGORY M. DIXON.....

Surveyed ..Sept..26. 19.85., by ..L. M. TOLL.....