


VI - LOCATION PLAT

T. **85** R. **43E**

Scale **6** inch = 1 MILE  
Meridian **WILLAMETTE**

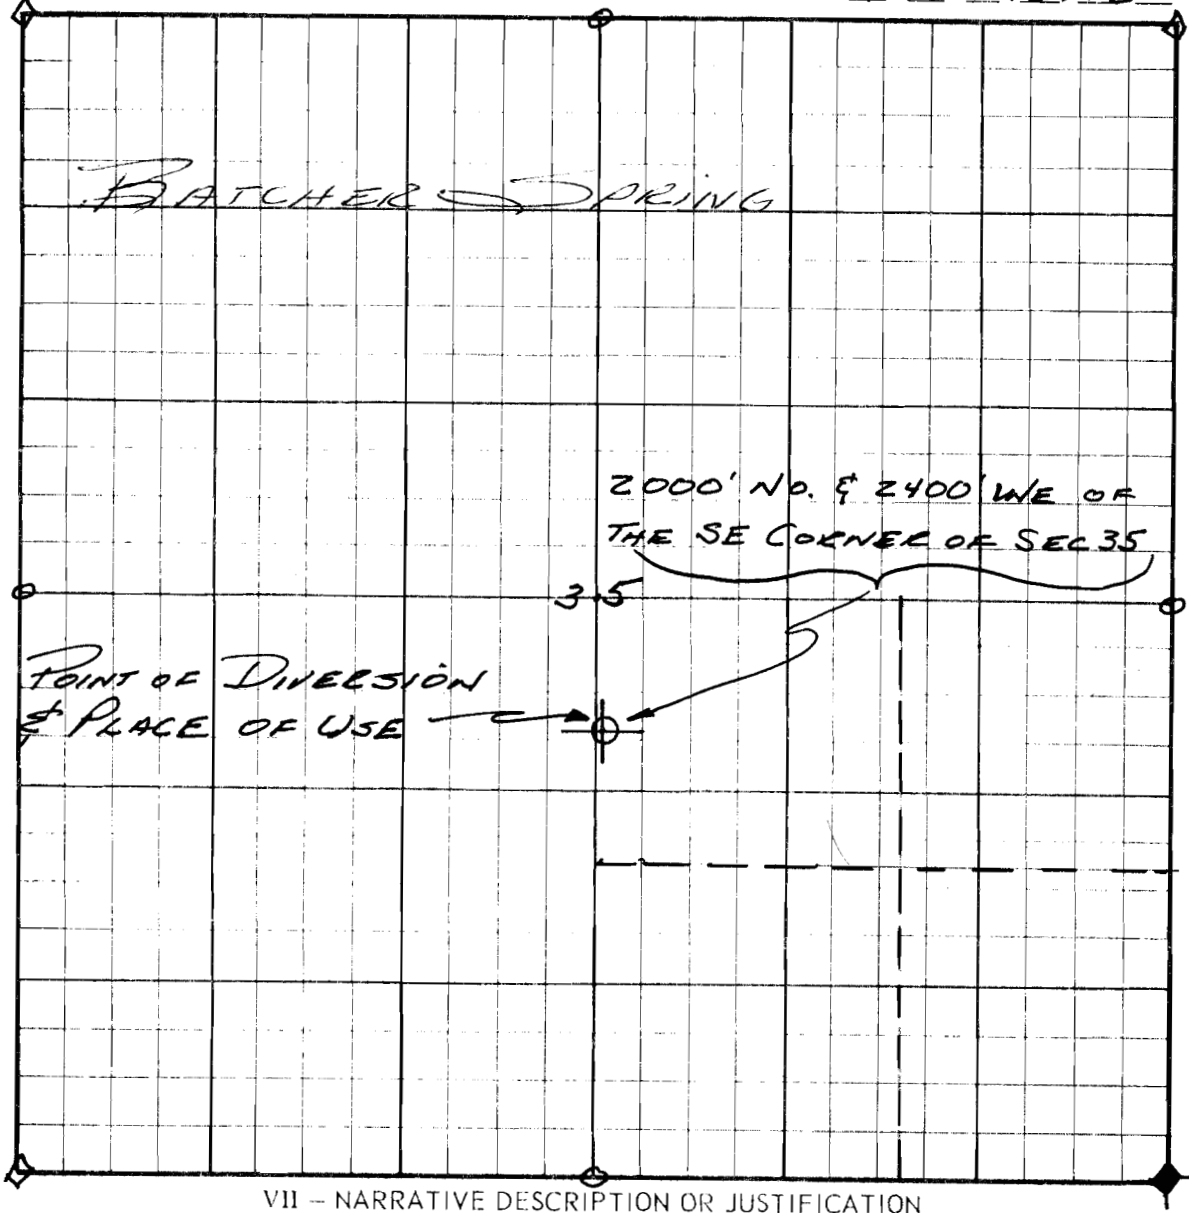

VII - NARRATIVE DESCRIPTION OR JUSTIFICATION

Point is  $45^{\circ} 49' 27.6''$   
&  $117^{\circ} 24' 40.6''$

Application No. **56803**

Permit No. **42598**

Prepared by *[Signature]*  
Approved by *[Signature]*

Title *Chief of Oper*  
Title *[Signature]*

Date **30/000/77**  
Date