


T.14S.,R.38&39E.,W.M.

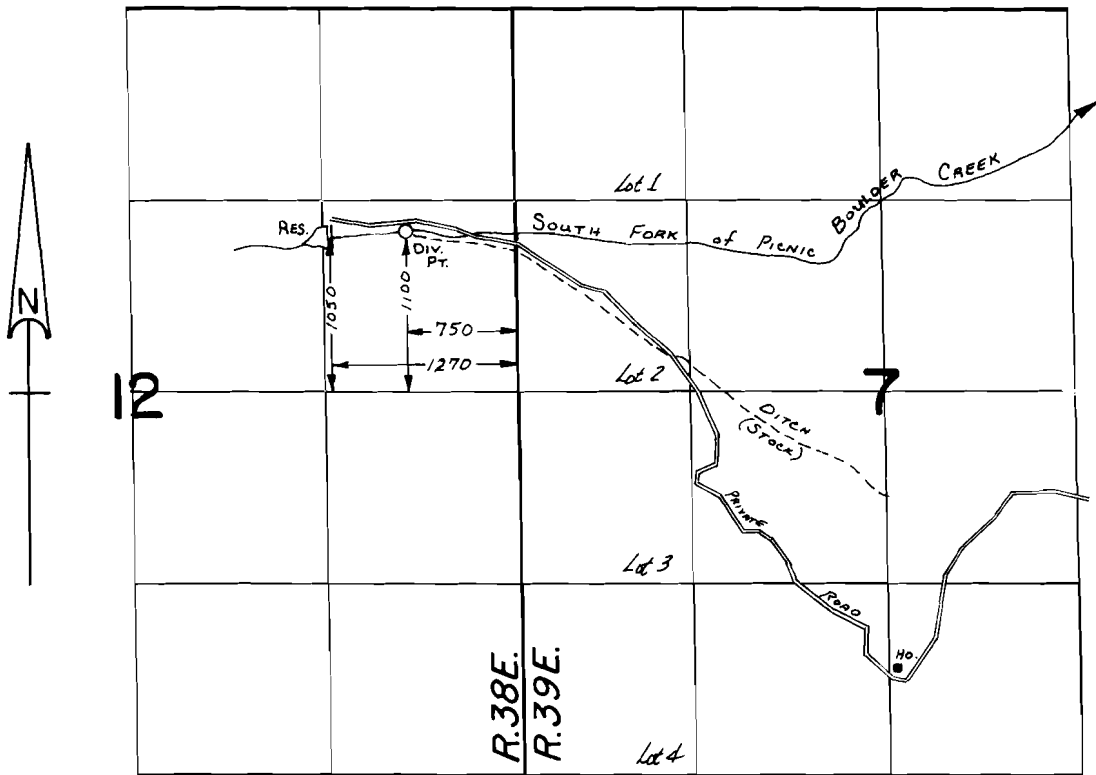

SCALE: 1" = 1320'

FINAL PROOF SURVEY

UNDER

R-59535 R-8160
Application No. 60235 Permit No. 44974
IN NAME OF

.....BERTHA DUNCAN.....

Surveyed Sept. 19, 1985, by L. M. TOLL.....
Oct. 1, 1985 L. M. TOLL

PTS 1985 Y-A LMT
41045-278-160L