


# T.14S., R.38&39E., W.M.

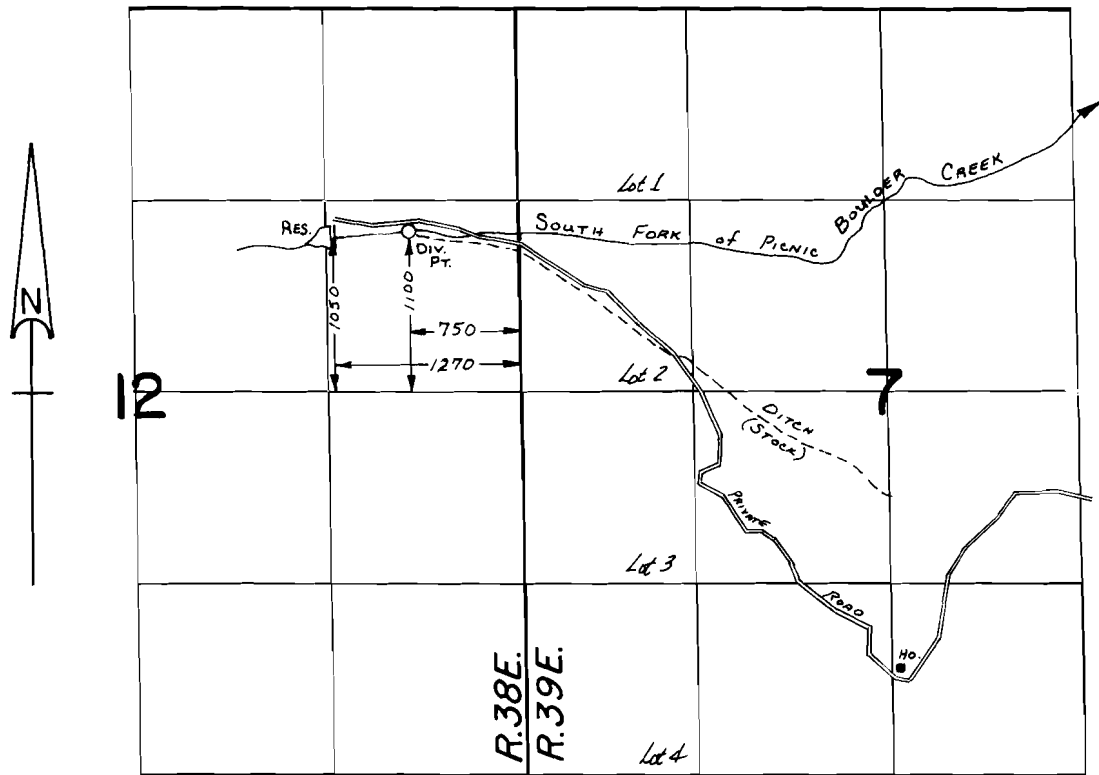

SCALE: 1" = 1320'

## FINAL PROOF SURVEY

UNDER

R-59535                      R-8160  
 Application No. 60235      Permit No. 44974  
 IN NAME OF

.....BERTHA DUNCAN.....

Surveyed Sept. 19, 1985, by L. M. TOLL.....  
 Oct. 1, 1985                      L. M. TOLL

PTS 1985 Y-A      LMT  
 41045-278-160L