


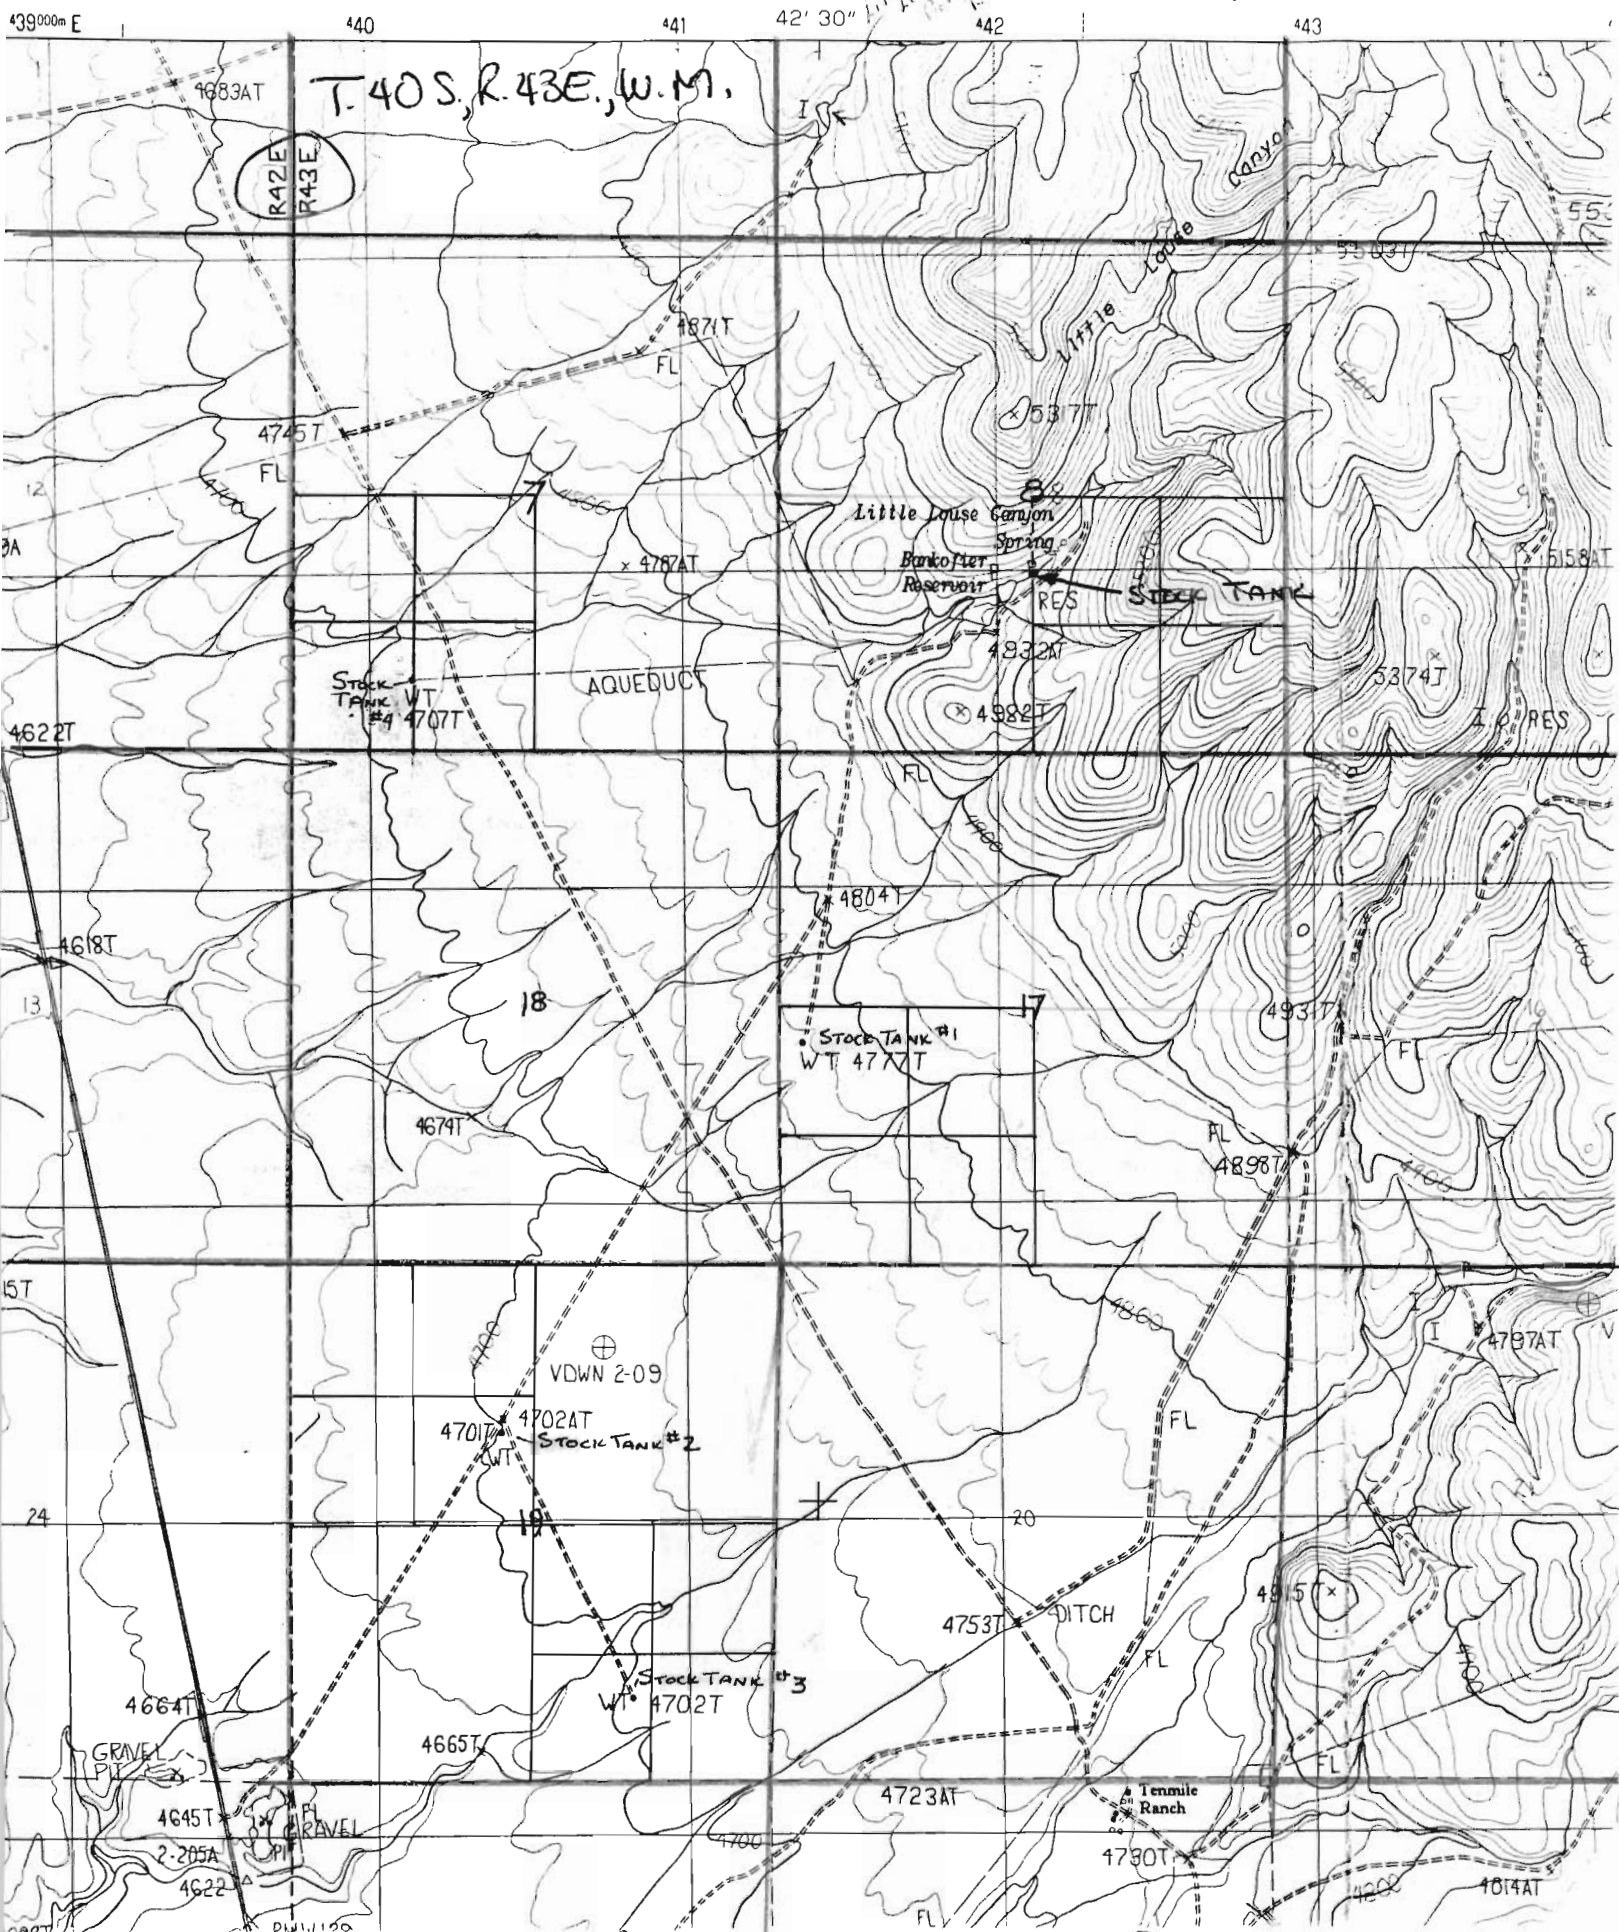

A copy of a portion of TEN MILE RANCH QUAD

4MT