


T. 14 S., R. 40 E., W. M.

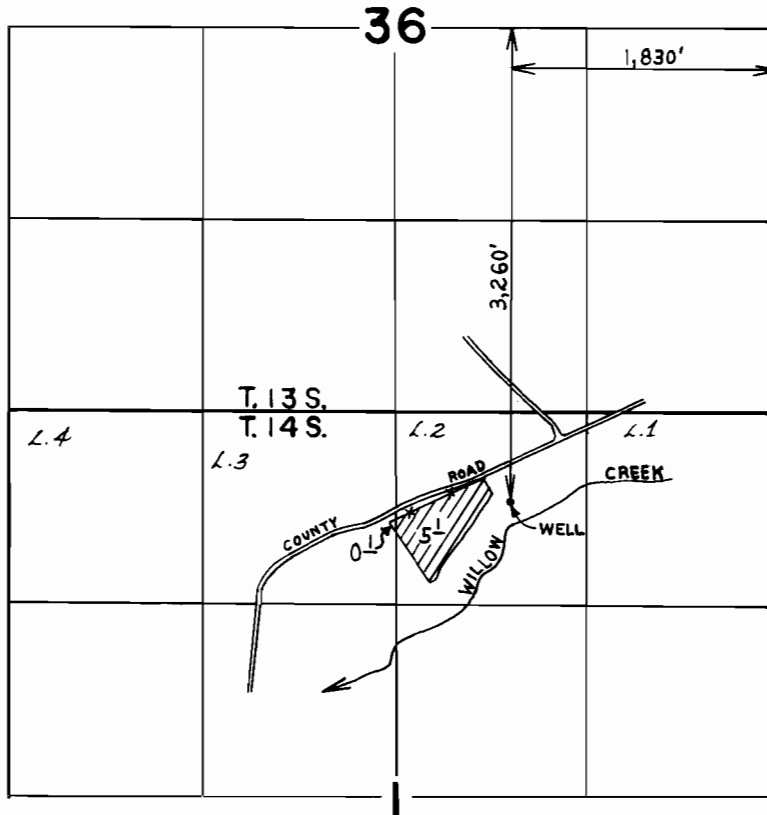

SCALE: 4" = 1 mile

FINAL PROOF SURVEY UNDER

Application No. G-8102 Permit No. G-7487....
IN NAME OF

RESERVOIR LAND CO.

Surveyed SEPT. 19, 1985, by L. TOLL