


T. 5 S., R. 1 W., W. M.

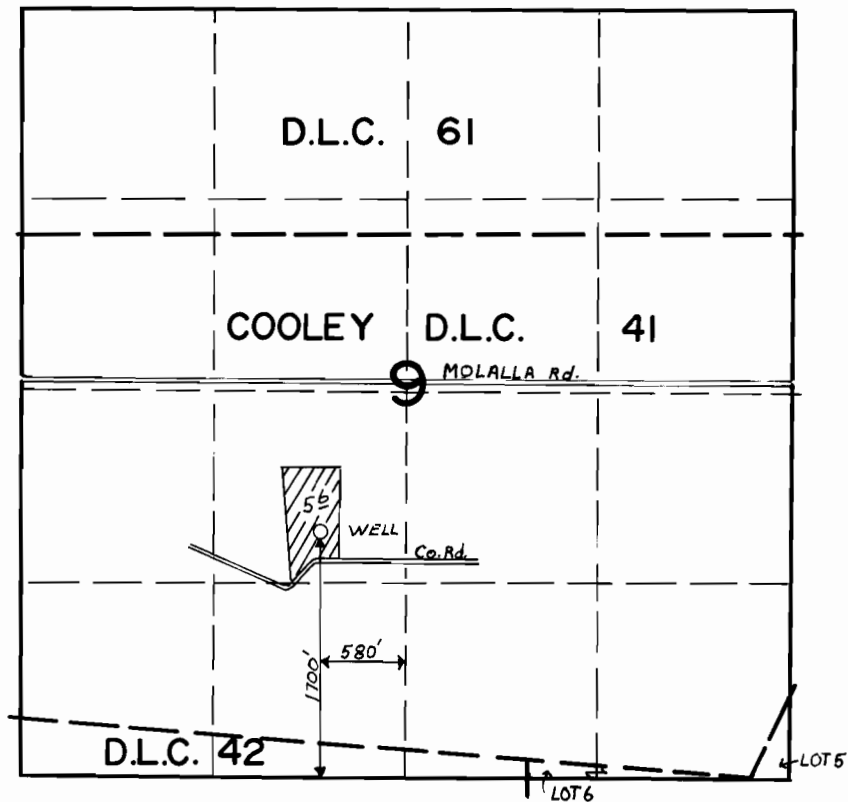

SCALE: 1"=1320'



FINAL PROOF SURVEY UNDER

Application No. G-9877. Permit No. G-9044.....
IN NAME OF

.....YAKOV KUZNETSOV.....

Surveyed Aug. 2..... 1984., by ..B.W.BISHOP.....