


P - 44217 54551
G-8587 54552
G-9548 54553

T. 1S., R. 18E., W. M.

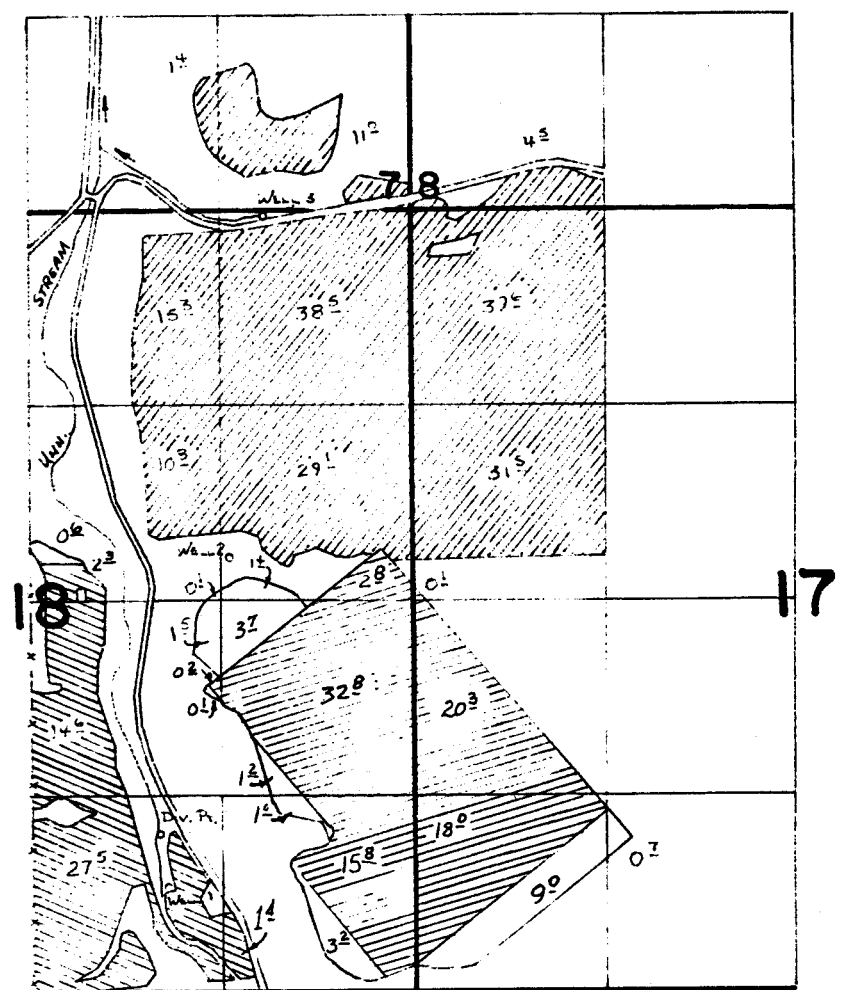

Div. Pt. located 1070' N. & 1760' W. From SE Cor. Section 18
Well 1 located 720' N. & 1700' W. From SE Cor. Section 18
Well 3 located 40' S. & 1010' W. From NE Cor. Section 18

 Pri. Per. 7421
Supp. Per. G-8587
 Pri.
Per. G-8587
 Well 3
Per. G-9548

FINAL PROOF SURVEY UNDER

58602 44217
G-9221 G-8587
Application No. G-9935 Permit No. G-9548
IN NAME OF
DONALD THOMPSON
Surveyed 5-8-1985, by V. L. Church