


T. 5N., R. 29E., W. M.

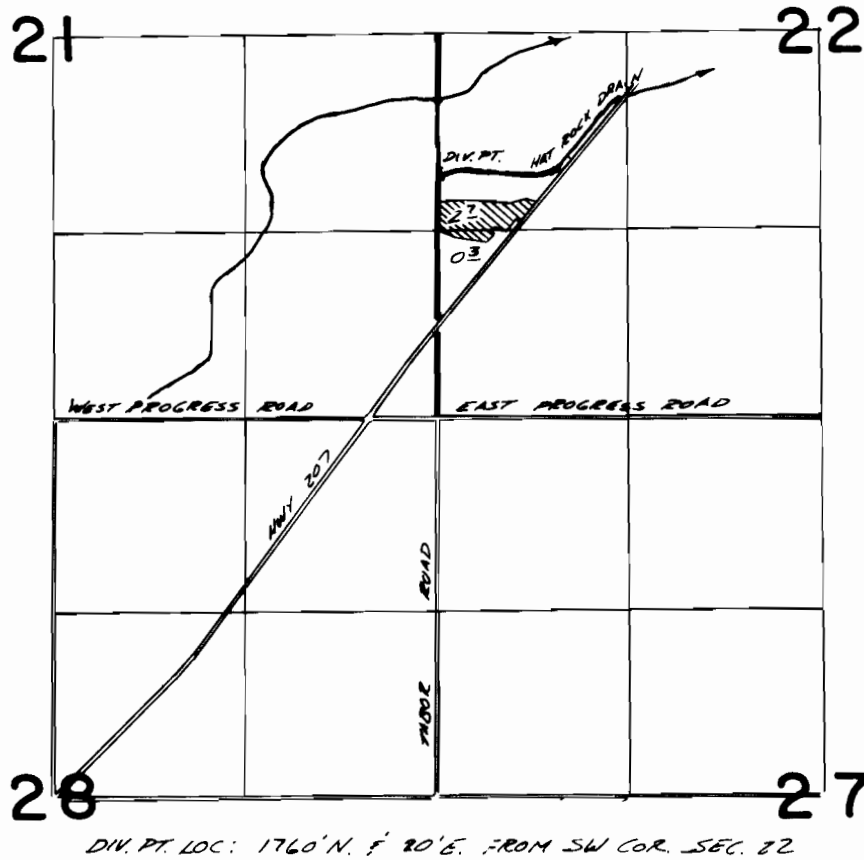

**FINAL PROOF SURVEY**  
UNDER

Application No. **60502** Permit No. **45296**...  
IN NAME OF

.....**WILLIAM R. JEPSEN**.....

Surveyed Aug. 3, 1982, by *V.L. Church*.....