


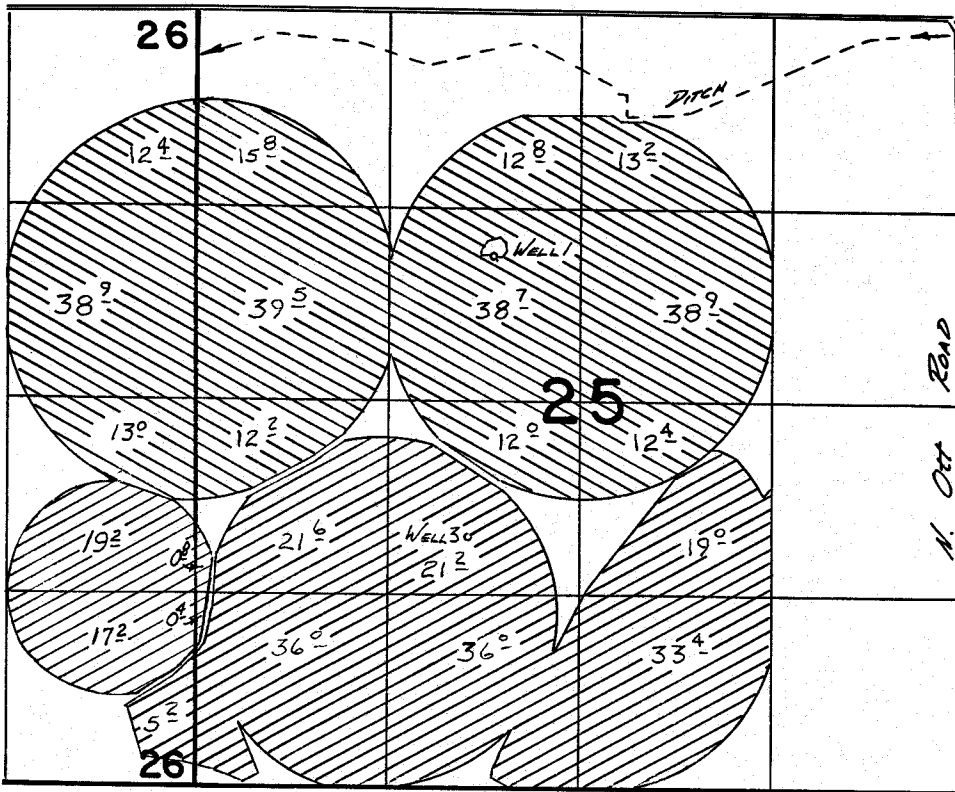

T. 5N., R. 28E., W. M.



WELL 1 LOC: 1000' N. & 600' W. FROM CENTER COR. SEC 25 G-6396   
 WELL 3 LOC: 920' S. & 760' W. FROM CENTER COR. SEC 25 G-9196 

**FINAL PROOF SURVEY**  
 UNDER

Application No. **G-6396** Permit No. **G-5985**  
**G-9196** **G-8588**  
 IN NAME OF

**BILL WOLFE RANCH, INC.**

Surveyed 6-16 1982, by V.L. Church