


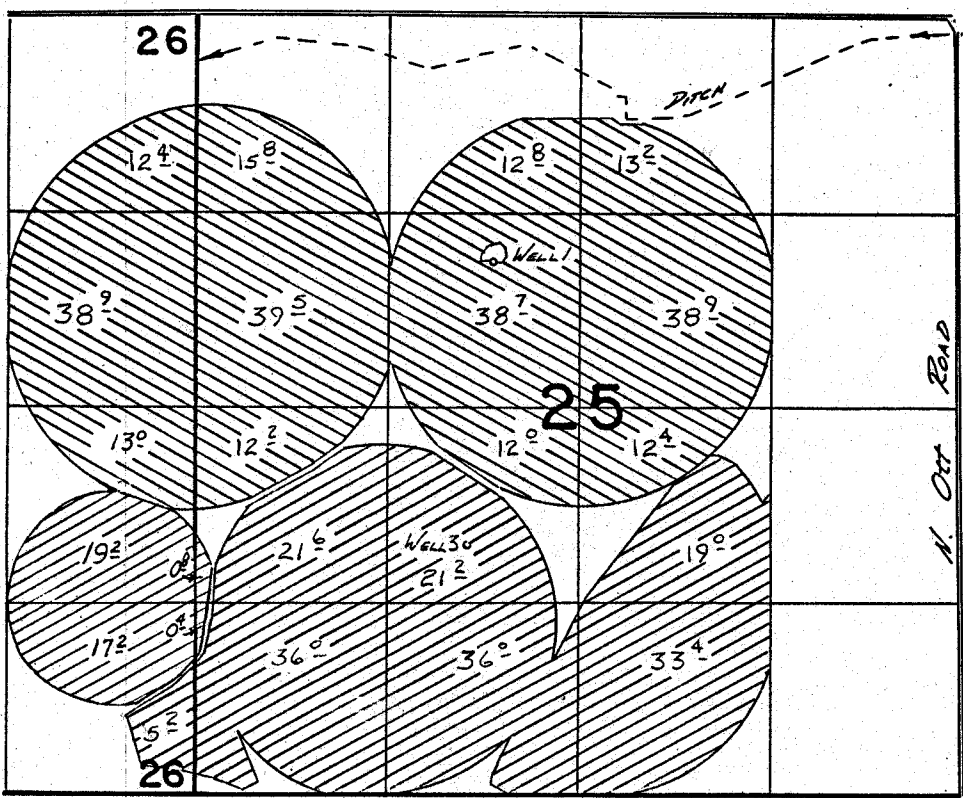

T. 5N., R. 28E., W.M.



WELL 1 Loc: 1000' N. & 600' W. FROM CENTER COR. SEC 25 G-6396   
 WELL 3 Loc: 920' S. & 760' W. FROM CENTER COR. SEC 25 G-9196 

**FINAL PROOF SURVEY**  
 UNDER

G-6396                      G-5985  
 Application No. **G-9196** Permit No. **G-8588**  
 IN NAME OF  
**BILL WOLFE RANCH, INC.**  
 Surveyed 6-16..... 1982., by V.L. Church...