


T. 2N., R. 28E., W. M.

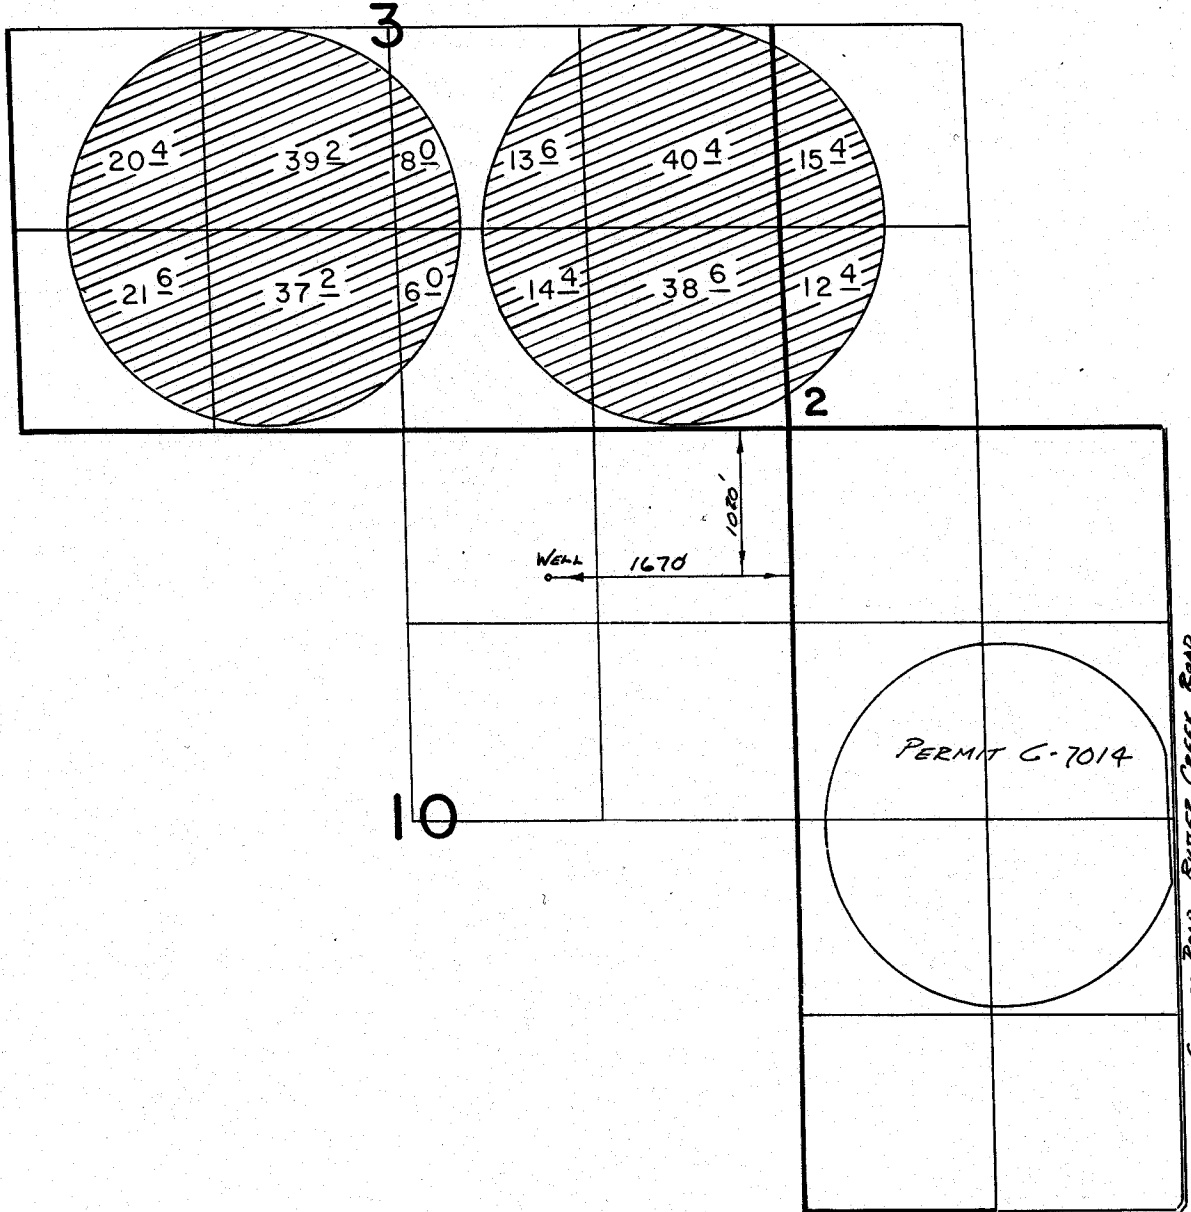

FINAL PROOF SURVEY
UNDER

Application No. G-7138 Permit No. G-6588
IN NAME OF

ROBERT G. SCHILLER

Surveyed 8-18 1982, by V.L. CURRAN