


T. 2N., R. 28E., W.M.

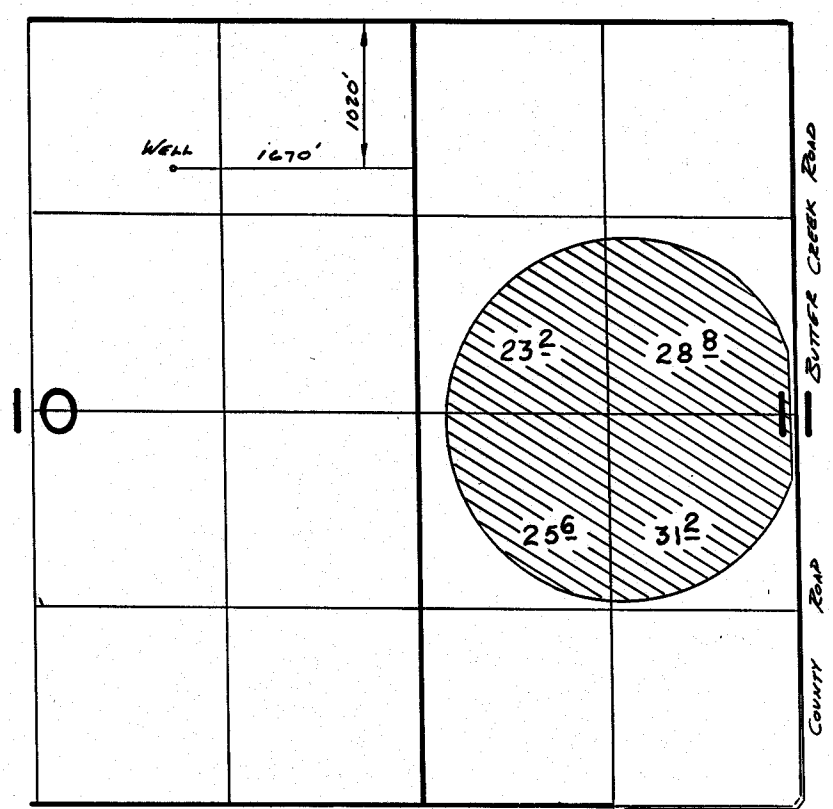

FINAL PROOF SURVEY
UNDER

Application No. G:7543 Permit No. G:7014
IN NAME OF

ROBERT.....ANTONE.....SCHILLER

Surveyed Aug. 18.... 1982., by V.L. CHURCH.....