


G-7108
54567

T. 1S., R. 32E., W. M.

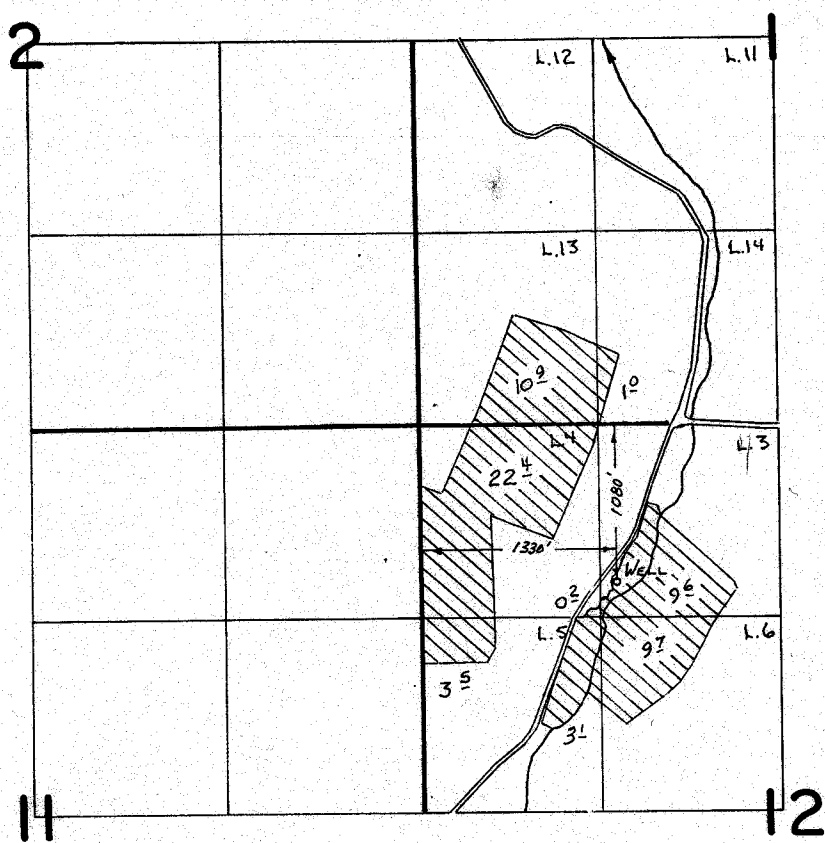

FINAL PROOF SURVEY
UNDER

SCALE: 1" = 1320'

Application No. G:7673. Permit No. G:7108....
IN NAME OF

.....**JOSEPH B. MILLER**.....

Surveyed ...5-19..... 1982., by V.L. Church.....