


T. 6N., R. 34E., W.M.

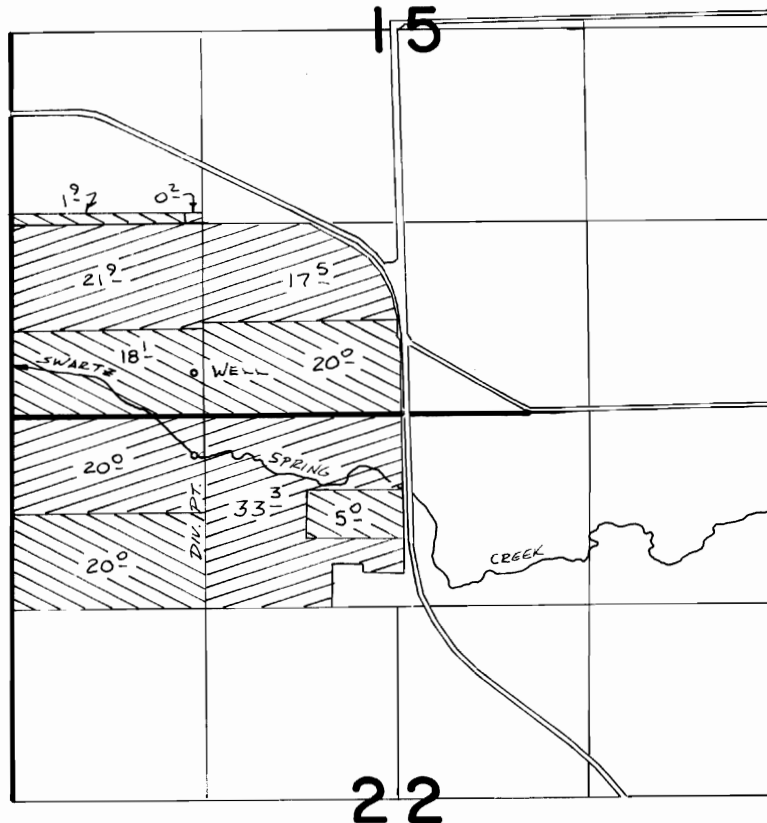

SCALE: 1" = 1320'

DIV. PT. LOCATED 260' S. & 1250' E FROM NW COR. SEC 22
 WELL LOCATED 300' N. & 1250' E FROM SW COR. SEC 15



SUPPLEMENTAL



PRIMARY

FINAL PROOF SURVEY UNDER

TRANSFER 3843

Application No. **G:8599** Permit No. **G:7973**
 IN NAME OF

PHILLIP L. HOON

Surveyed 9-21-1978, by **R. BAYLUM**
 3-22 84 **V. Church**