


T. 2N., R. 33E., W.M.

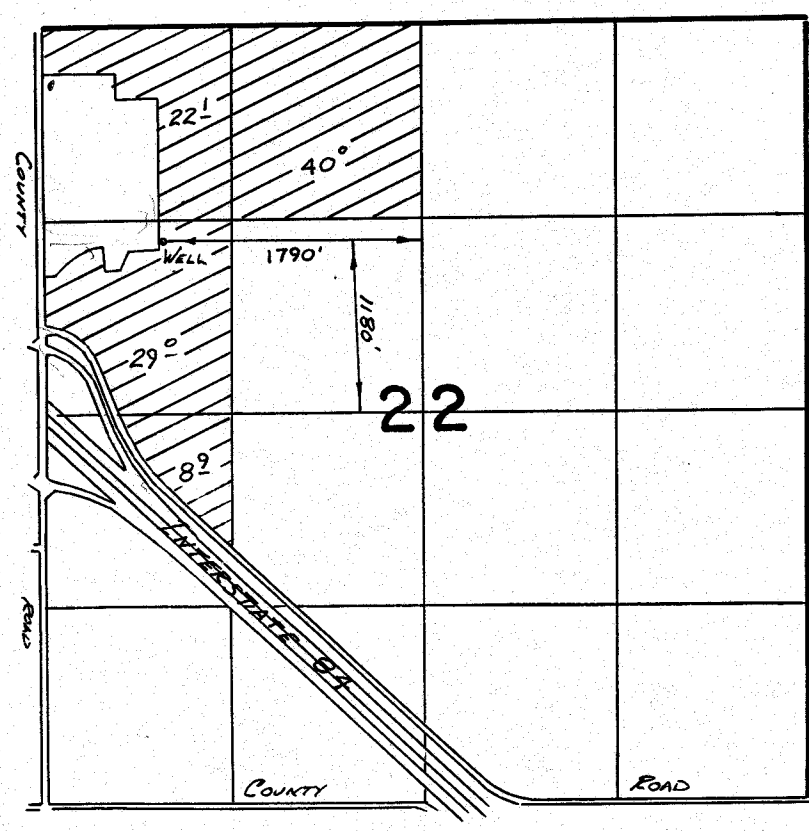

FINAL PROOF SURVEY
UNDER

Application No. G-9857 Permit No. G-9052
IN NAME OF

..... WILLARD E. RONDE

Surveyed JUNE 15, 1982, by V. CHURCH