


6-9259

54574

T. 2N., R. 33E., W. M.

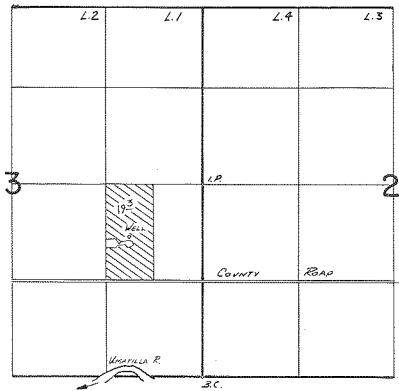

WELL LOC: 720'S. & 1010'W. FROM E 1/4 COR. SEC 3

**FINAL PROOF SURVEY**  
UNDER

Application: No. G:9595. Permit No. G:9259.  
IN NAME OF

..... BURL L. BECKER .....

Surveyed Aug. 4, 1982, by *W. L. ...*