


T. 5N., R. 29E., W.M.

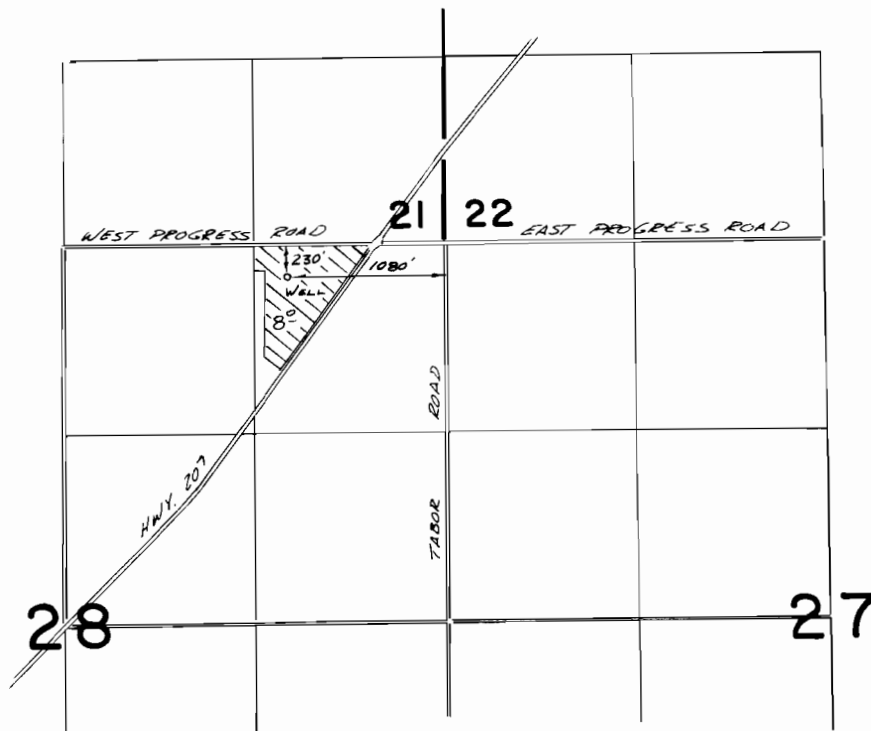

FINAL PROOF SURVEY
UNDER

Application No. **G:9850** Permit No. **G:9270**...
IN NAME OF

.....**WENDELL A. GROSS**.....

Surveyed *July 28*... 1982., by *V.L. Church*.....