


G-10078
54577

T. 2 N., R. 33 E., W.M.

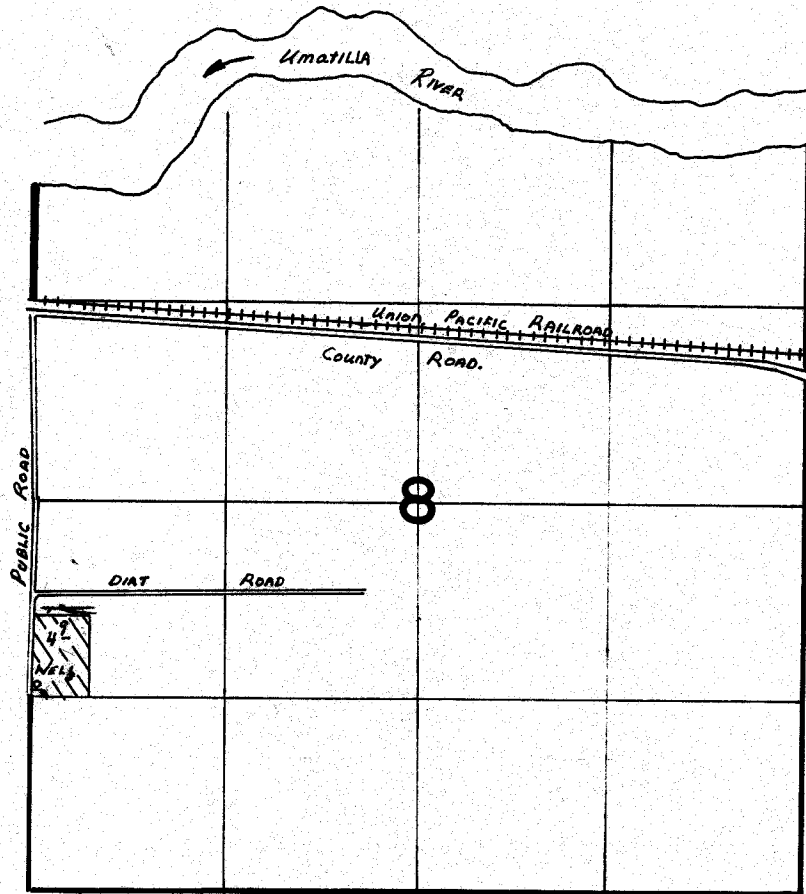

WELL Loc: 1250' S. & 30' E. FROM W¹/₄ COR. SECTION 8

FINAL PROOF SURVEY
UNDER

Application No. G-10950. Permit No. G-10078...
IN NAME OF

.....WILLIAM JOHNSON.....

Surveyed NOV. 29, 1983., by V.L. CHURCH.....