


T. 1N. R. 38E. W.M.

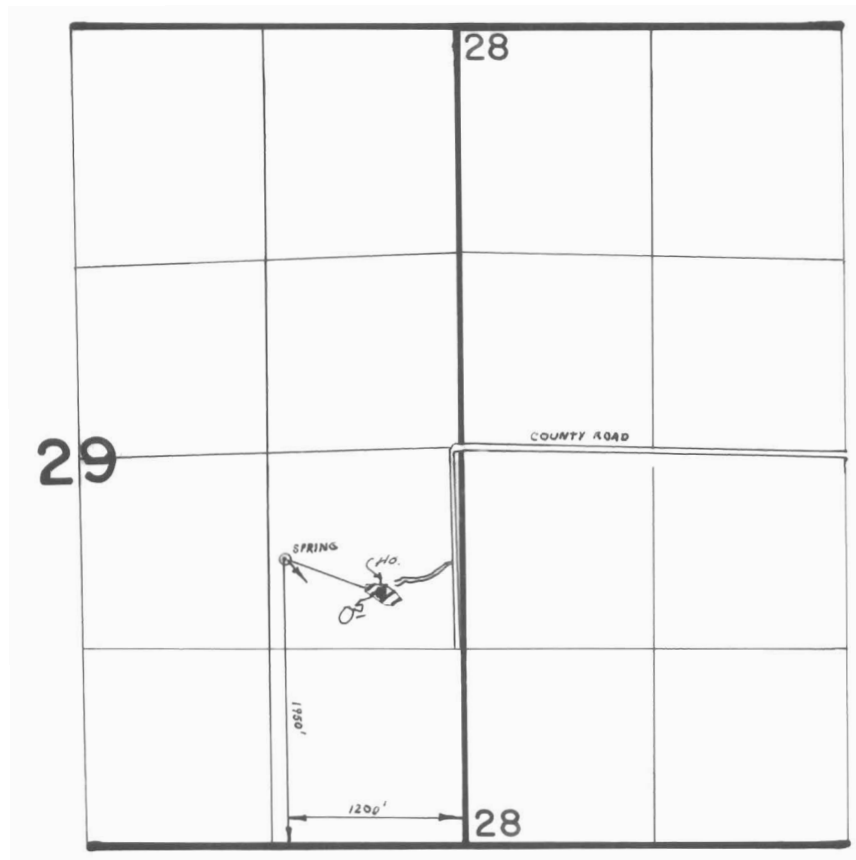

FINAL PROOF SURVEY
UNDER

Application No. 49594... Permit No. 37213...
IN NAME OF

.....DOROTHY J. McCURDY.....

Surveyed JULY 24 1980, by V. CHURCH.....