


T. 1N., R. 39E., W. M.

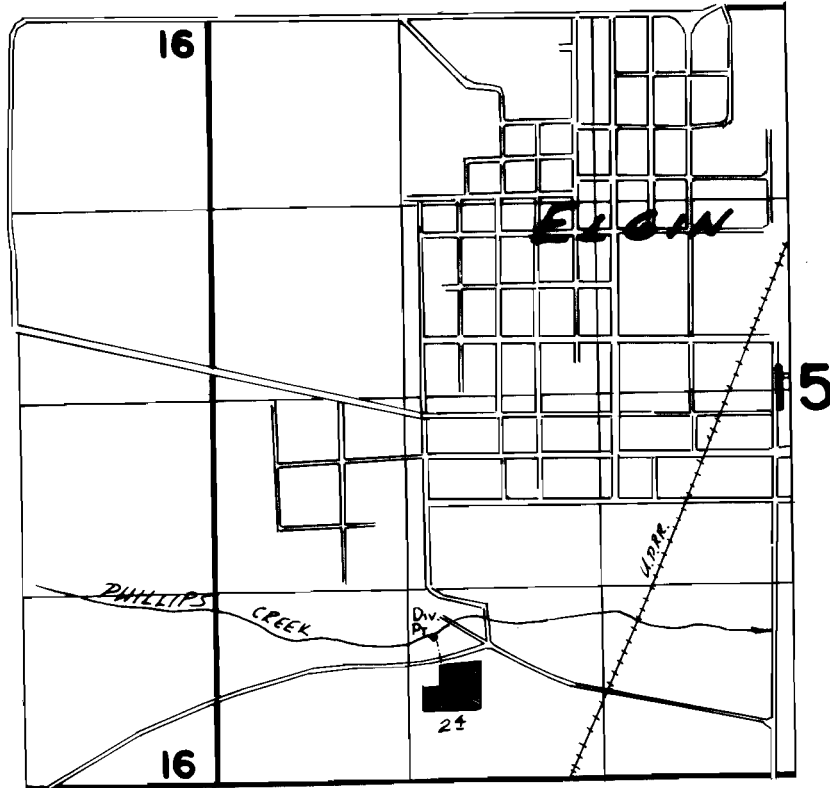

Div. Pt. Loc: 990' N. & 1500' E. FROM SW COR. SEC 15

FINAL PROOF SURVEY
UNDER

Application No. **54418** Permit No. **40806**..
IN NAME OF

FINCHER & SONS, INC.

Surveyed *Aug. 23*.. 19*83*.. by *W. L. Church*.....