


T. 5N., R. 43E., W.M.

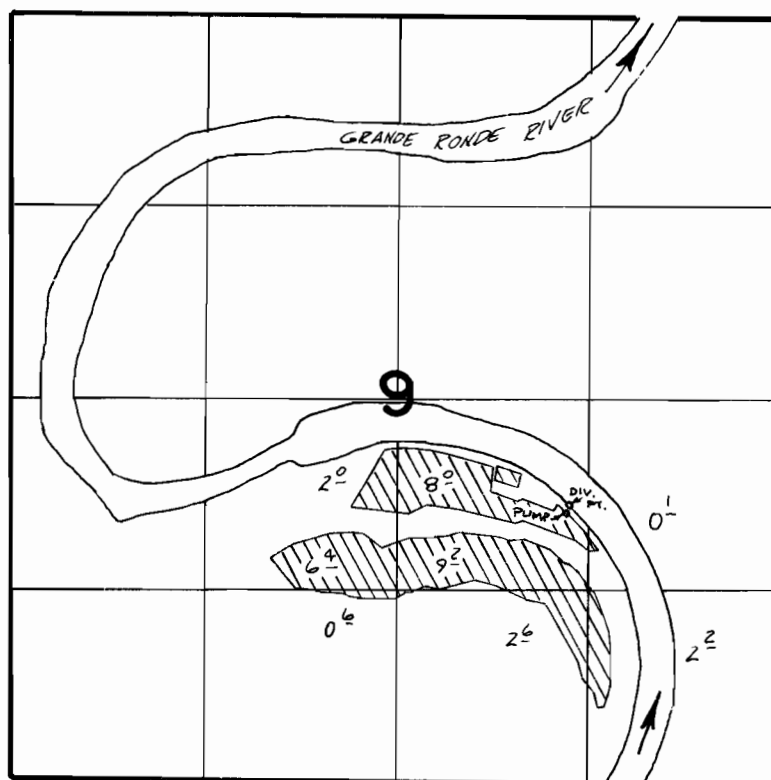

DIV. PT. LOCATED 1910'N & 1440'W. FROM SE COR. SEC 9

FINAL PROOF SURVEY
UNDER

Application No. 51828 Permit No. 39029
IN NAME OF

LESTER E. KIESECKER

Surveyed Aug. 12, 1981, by Thomas L. Church