

42116


1870.0'

17 16 21


EXISTING WATER LEVEL ELEVATION
 NEW WATER LEVEL ELEVATION
 SCALE IN FEET

GRATES PI. PUBLIC FISHING LAKE
 COLUMBIA

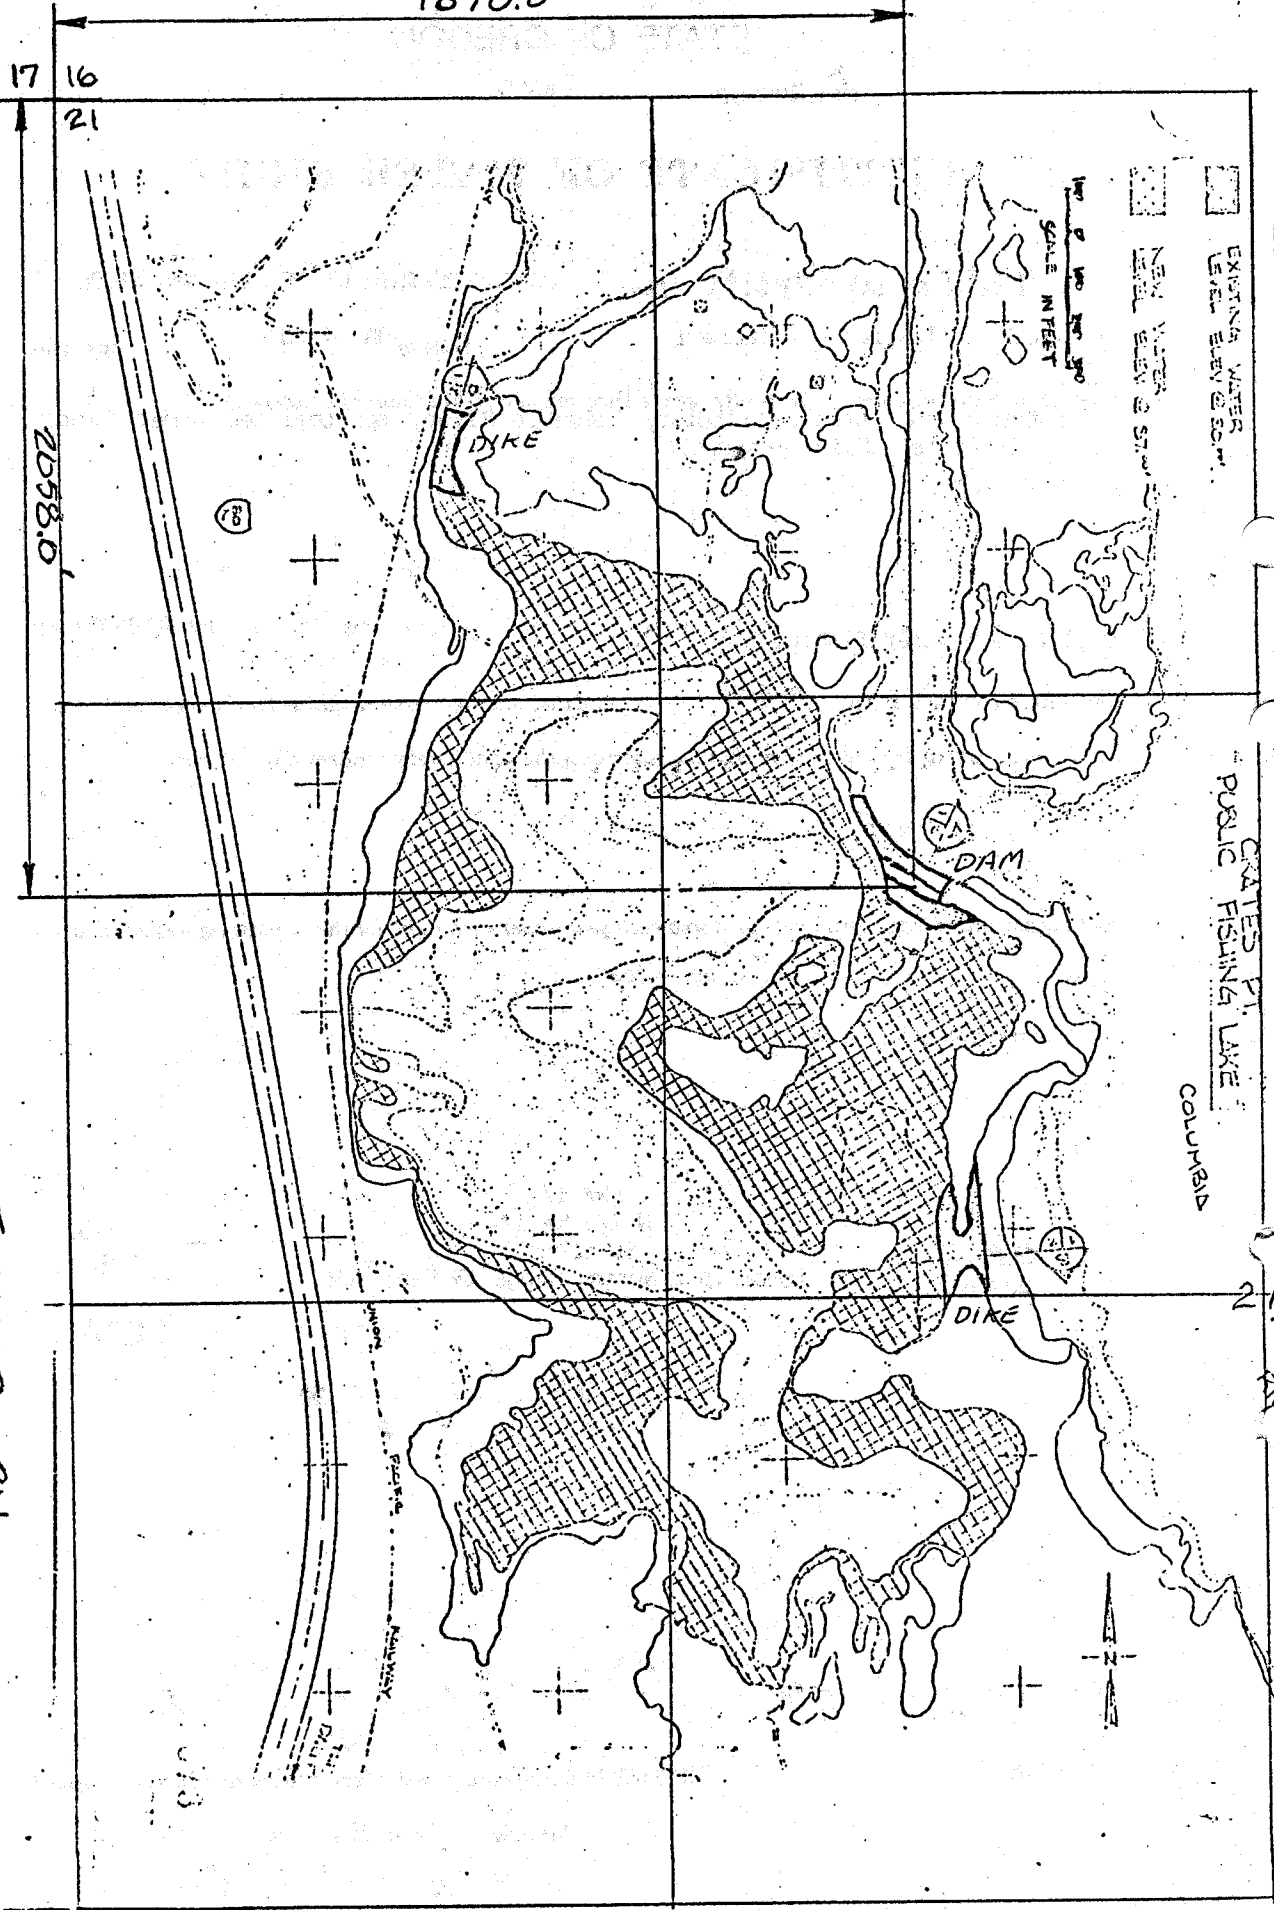

Application No. R 56677, 56678
 Permit No. R 6891, 42776

DEPT. OF FISH & WILDLIFE

TOWNSHIP 2N
 RANGE 13E
 SECTION 21

DRAWN BY JELU
 Nov. 2, 1977