
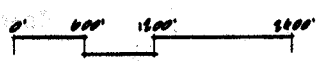


Application No. G-7468
Permit No. G-7131

WELL NO. 2
ORIGINAL 1973
WELL NO. 1
NEW 1976

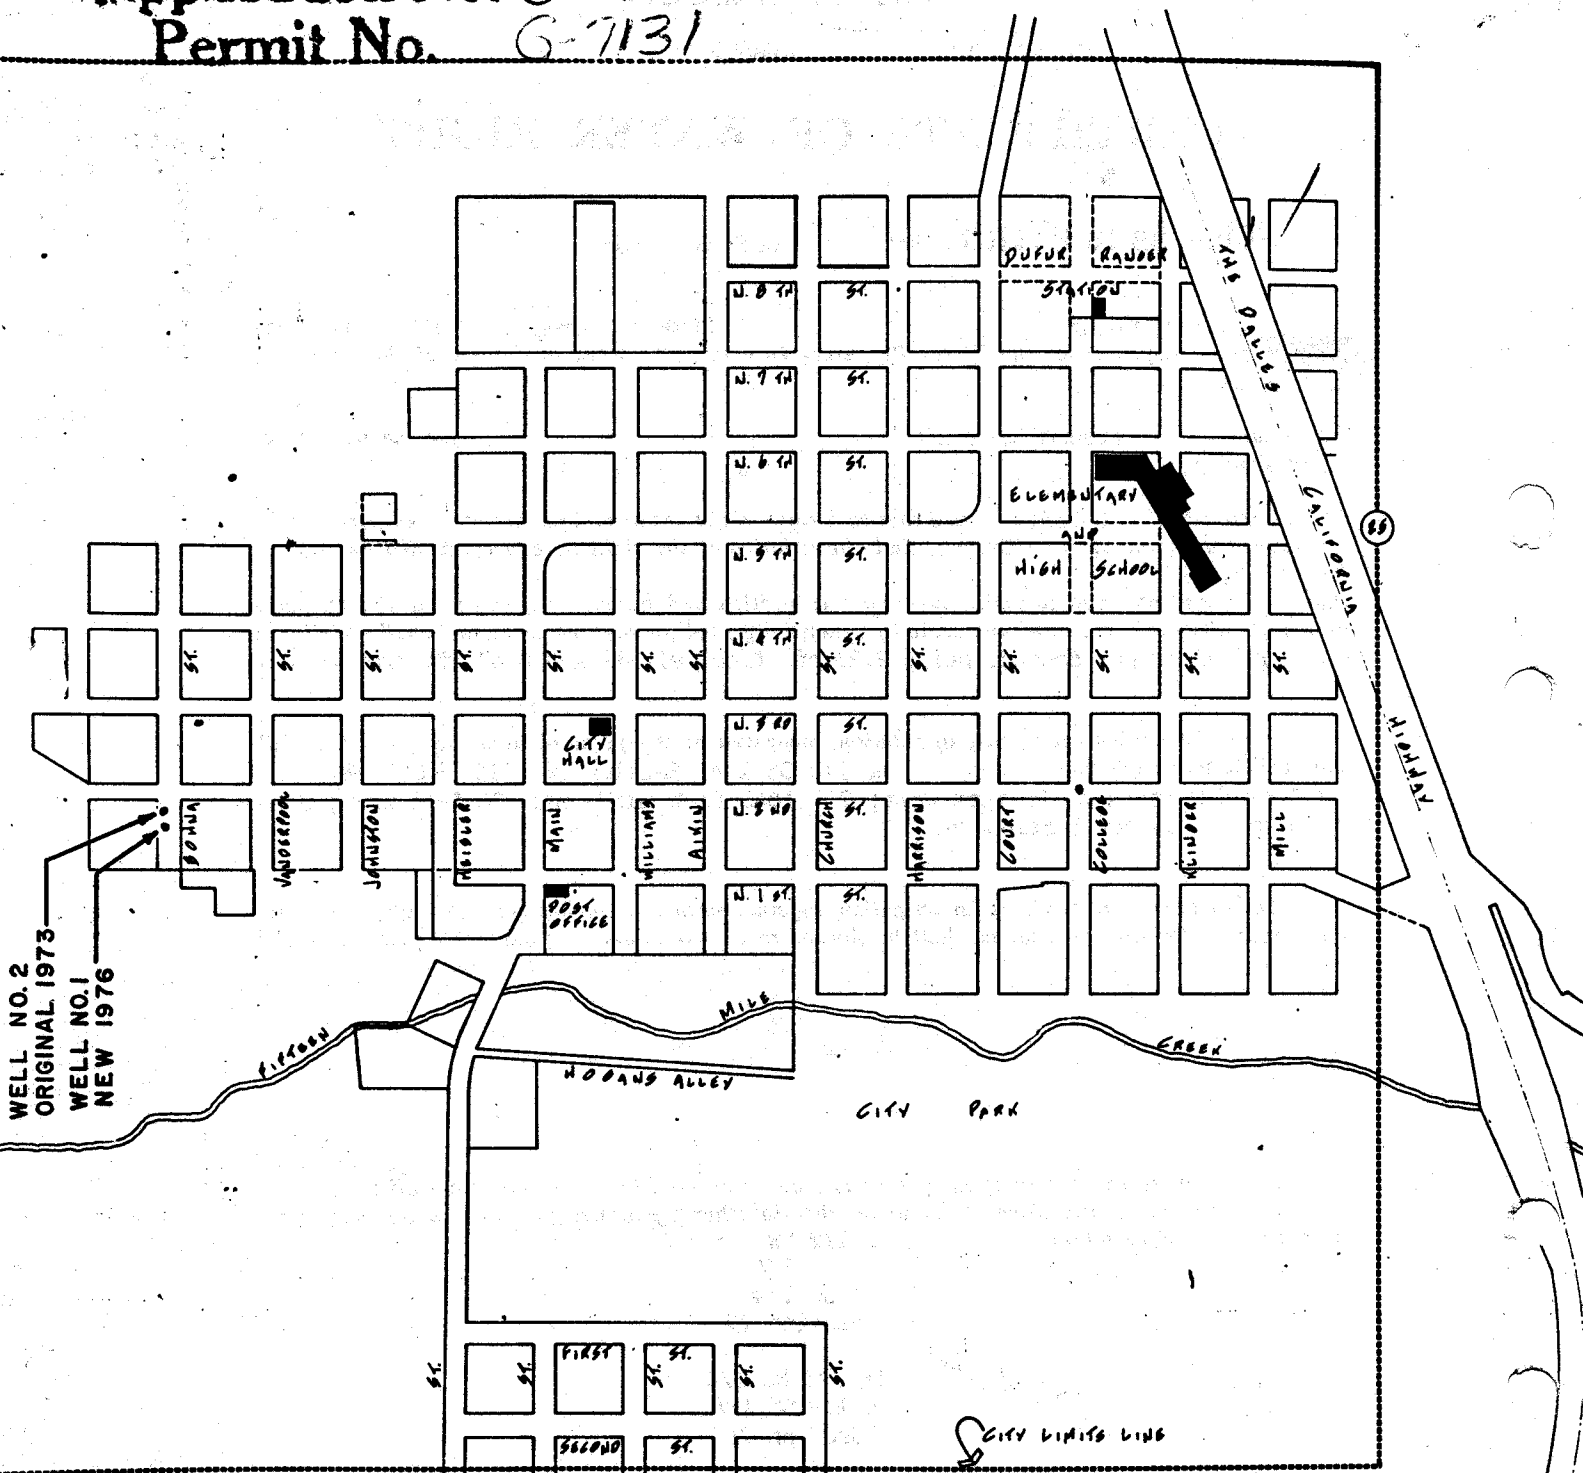

DUFUR
WELL LOCATIONS 7-15-76

RECEIVED
JAN 10 1977
WATER RESOURCES DEPT
SALEM, OREGON

RECEIVED
AUG - 5 1976
WATER RESOURCES DEPT
SALEM, OREGON