# T. 2 N. R. 13 E. W.M.

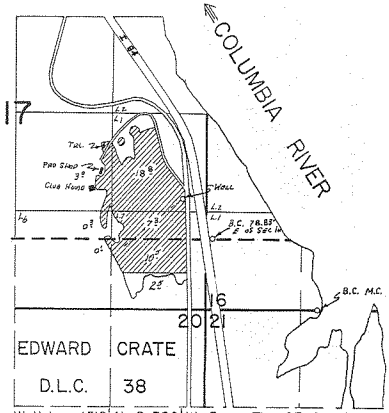


Well Loc. 1510' N. & 320' W. From The SE Cor. Sec 17

## FINAL PROOF SURVEY
UNDER

Application No. G-5674 Permit No. G-5495
IN NAME OF

THE DALLES COUNTRY CLUB

Surveyed Dec. 3, 1981., by T. PAUL

Photo 572-37