


T.27S.,R.7W.,W.M.

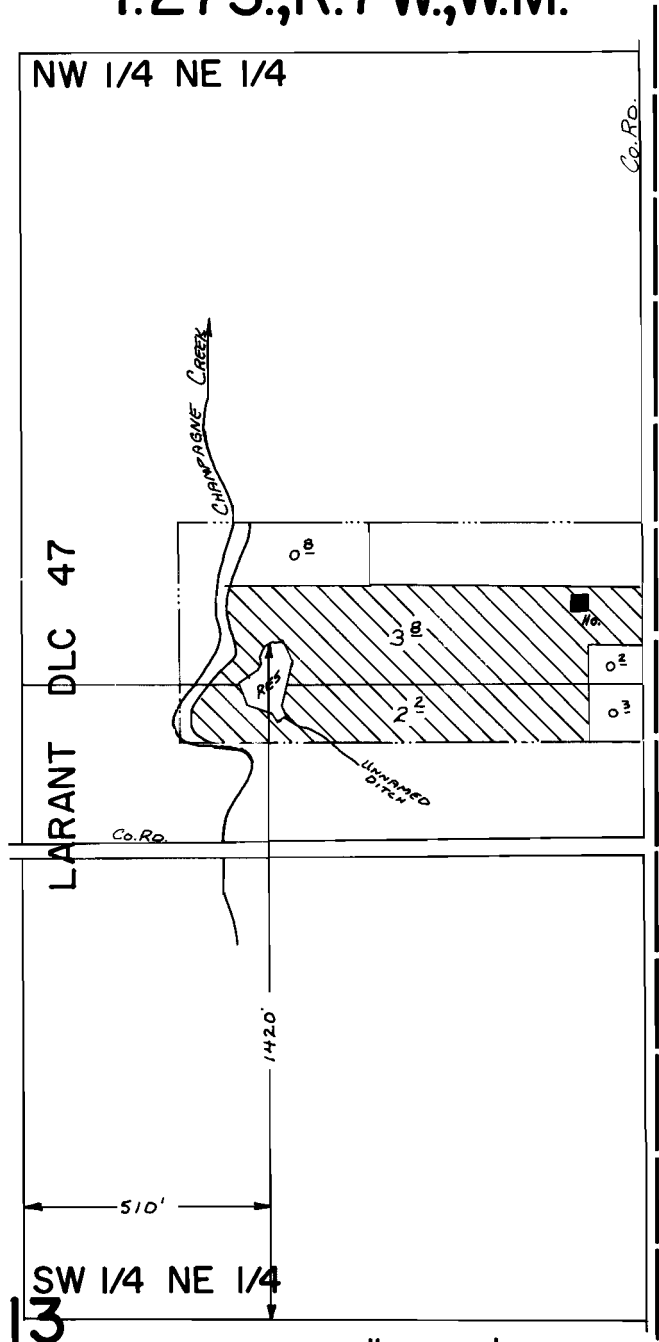

SCALE: 1" = 400'

FINAL PROOF SURVEY
UNDER

Application No. R-55586 55587 Permit No. R-6750 42560
IN NAME OF

JERRY BILL KINGSBURY

Surveyed June 23, 1982, by L. M. TOLL