


T.27S.,R.7W.,W.M.

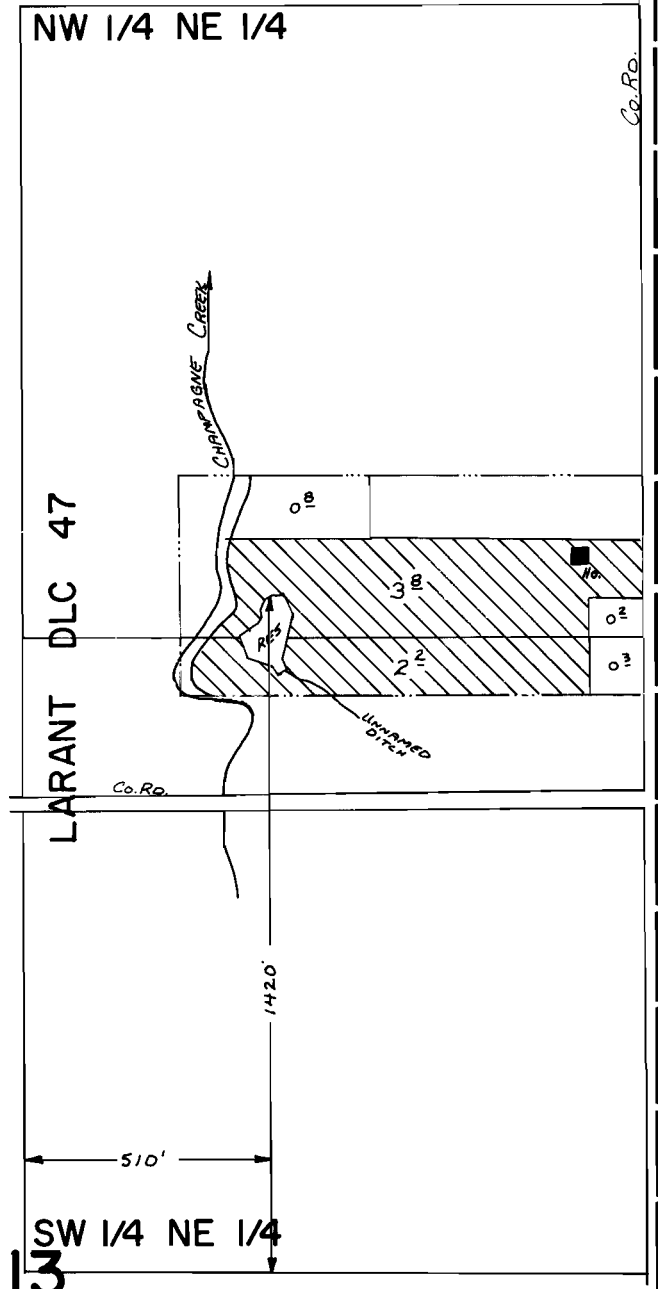

SCALE: 1" = 400'

**FINAL PROOF SURVEY**  
UNDER

Application No. R-55586 Permit No. R-6750  
...55587... 42560...  
IN NAME OF

JERRY BILL KINGSBURY

Surveyed June 23, 1982, by L. M. TOLL