


T.28S.,R.7W.,W.M.

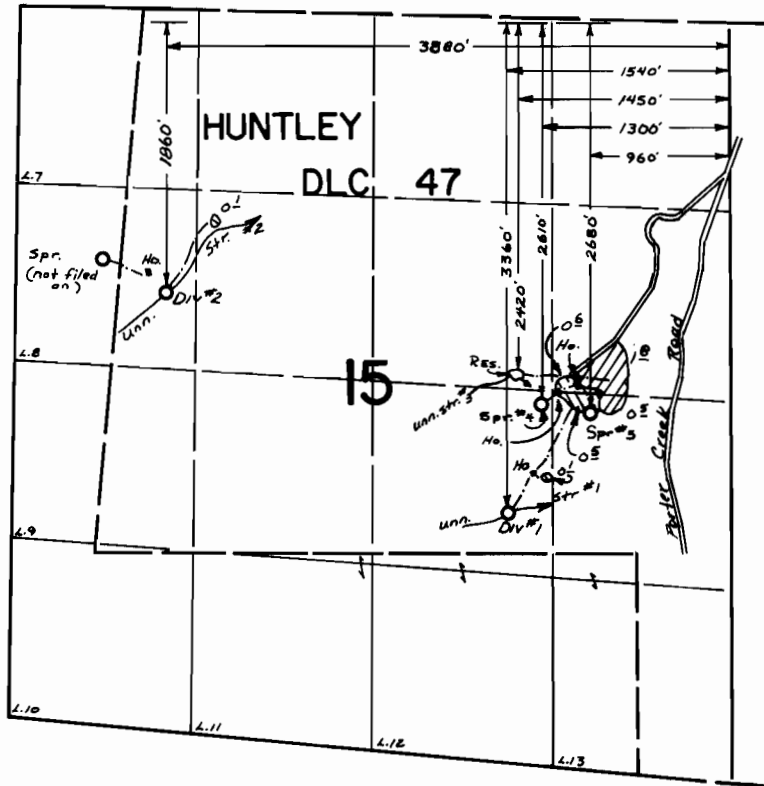

-  STREAM #1
-  STREAM #3

FINAL PROOF SURVEY UNDER

Application No. 56000 Permit No. 42811
R-56001 R-6895
 IN NAME OF

JOHN ERIC LIND

Surveyed June 6 1979, by J.S. DONALDSON