


# T.28S.,R.7W.,W.M.

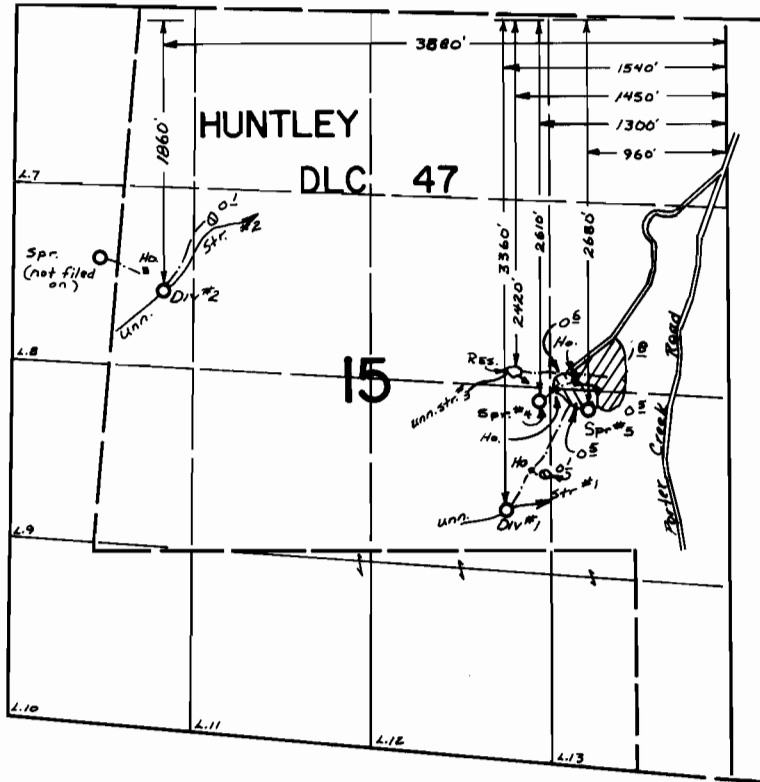

-  STREAM # 1
-  STREAM # 3

## FINAL PROOF SURVEY UNDER

Application No. 56000 Permit No. 42811  
R-56001 R-6895  
 IN NAME OF

JOHN ERIC LIND

Surveyed June 6 1979, by J.S. DONALDSON