


T. 26S., R. 3W., W.M.
SEC. 19

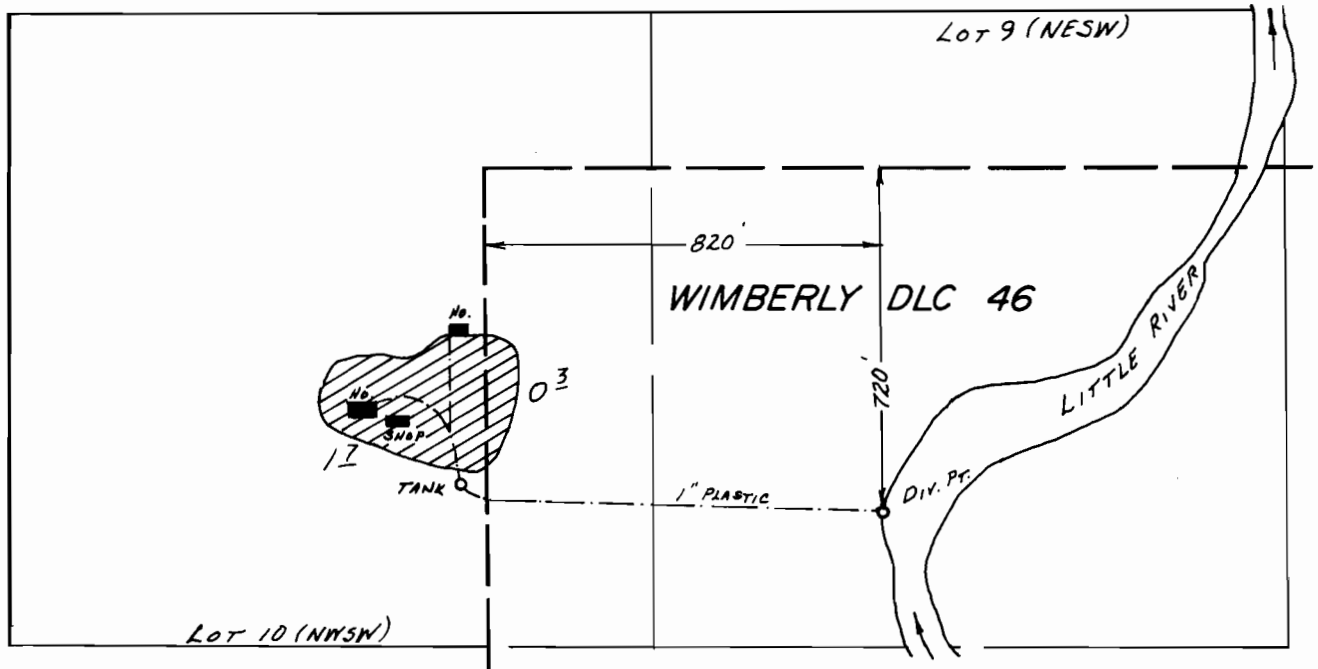

SCALE: 1" = 400'

FINAL PROOF SURVEY
UNDER

Application No. 58272.. Permit No. 39906.....
IN NAME OF

.....WANDA LEE BALLARD.....

Surveyed JAN..23.. 1980., by J.S. DONALDSON