


T. 26S., R. 3W., W.M.
SEC. 19

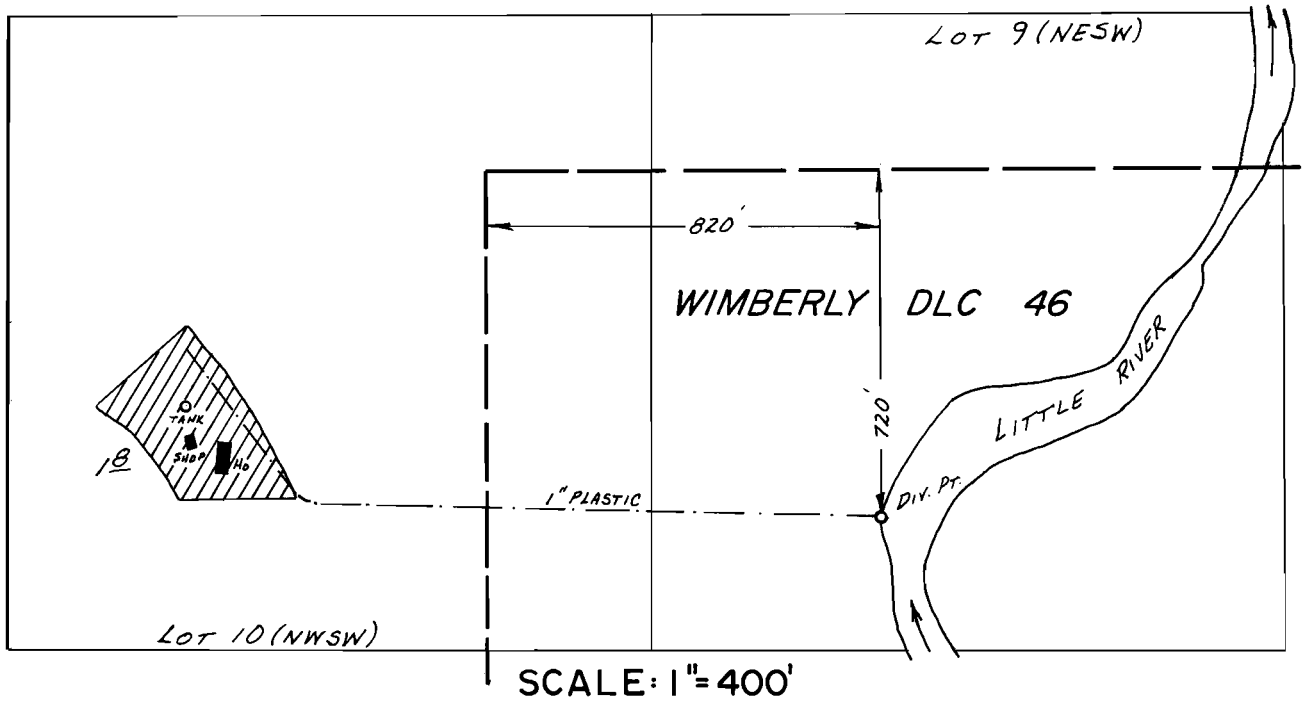

FINAL PROOF SURVEY
UNDER

Application No. 53214... Permit No. 39488.....
IN NAME OF

.....CLARK L. HADFIELD.....

Surveyed JAN. 23. 1980., by J.S. DONALDSON