


T. 27S., R. 3W., W.M.

SEC. 2

NWSW

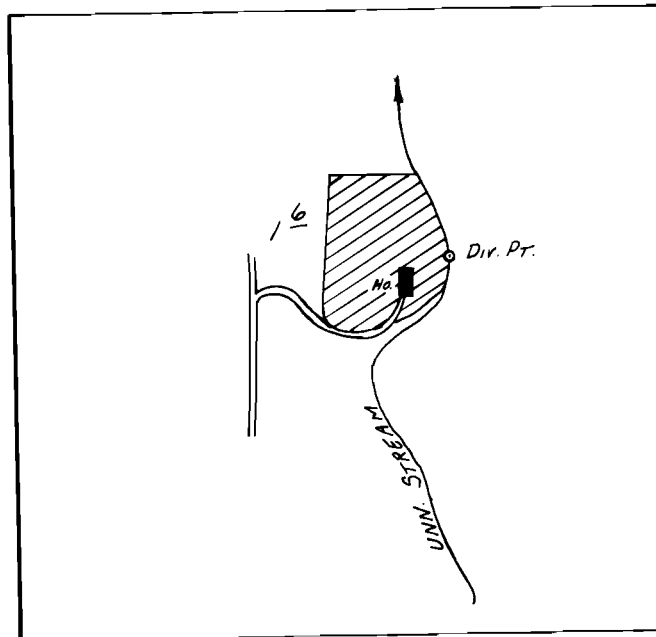

Dir. Pt. Loc.: 510'S. & 910'E. FROM W 1/4 COR. SEC. 2

SCALE: 1" = 400'

FINAL PROOF SURVEY
UNDER

Application No. 53552 Permit No. 41228
IN NAME OF

TOM T. OR RUTH A. STEWART

Surveyed MAY 13 1980, by J. S. DONALDSON