T. 26S., R. 3W., W.M.

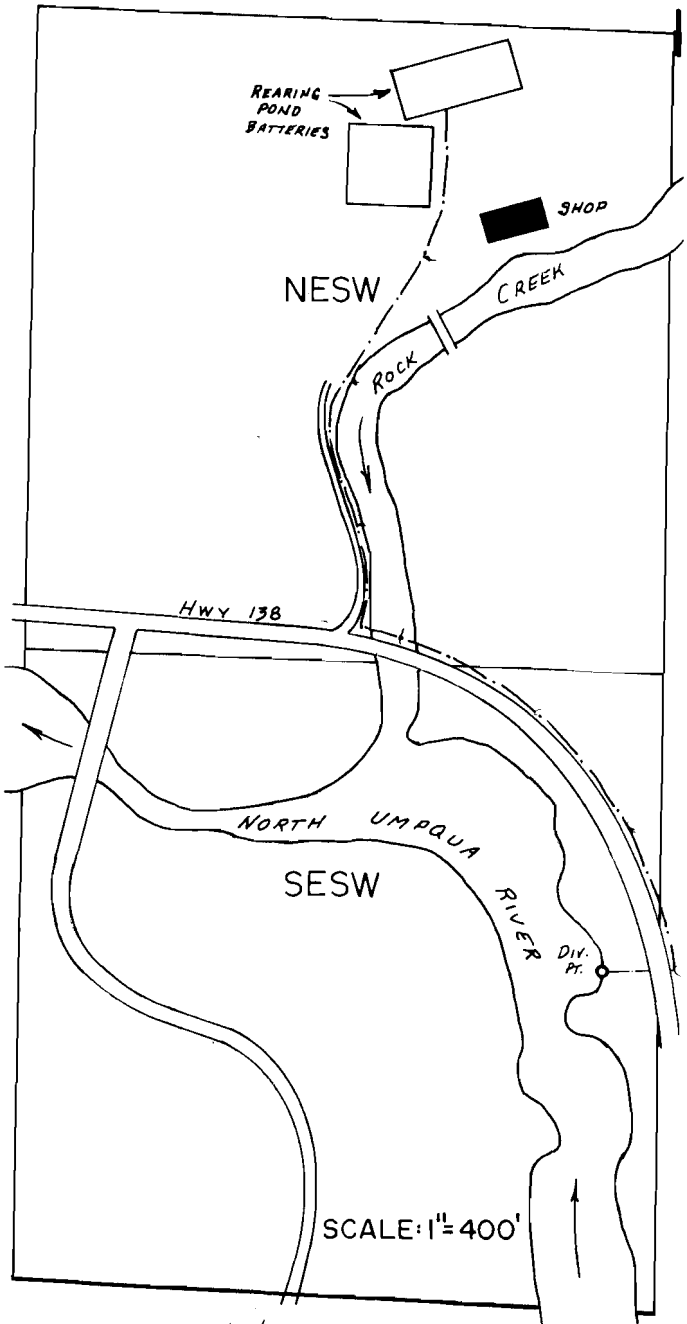

DIV. PT. LOC.: 1955' S. & 110' W. FROM C. 1/4 COR. SEC. 1. (A. # 54881)
DIAMOND LAKE DIV. LOC.: 150' N. & 250' E. FROM SW COR.
SEC. 30, T. 27 S., R. 6 E., W.M. (A. # 57861)

FINAL PROOF SURVEY

UNDER

Application No. 57861 54881 Permit No. 43627 41447

IN NAME OF

OREGON DEPARTMENT OF FISH & WILDLIFE

Surveyed JAN. 22 19 80, by J.S. DONALDSON

DOUG. CO. 78-24-26 BWB