


T.26S. R.6¹/₂W. W.M.

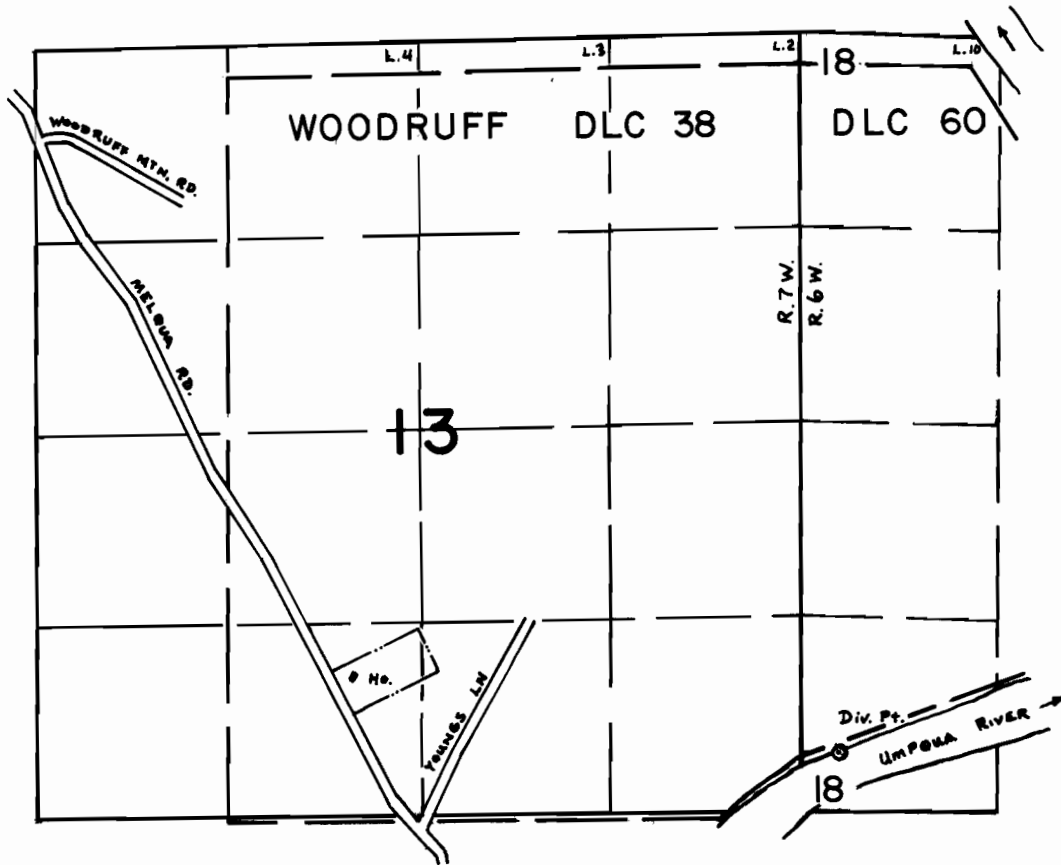

Div. Pt. Located 400' N & 240' E from SW Cor. of Sec. 18 T.26S. R.6W. W.M.

SCALE: 4" = 1 mile

FINAL PROOF SURVEY
UNDER

Application No. 55760 Permit No. 41756
IN NAME OF
JOHN E. WHELAND

Surveyed June 20, 1979, by S. Donaldson