


T. 27S., R. 6W., W.M.
SEC. 14

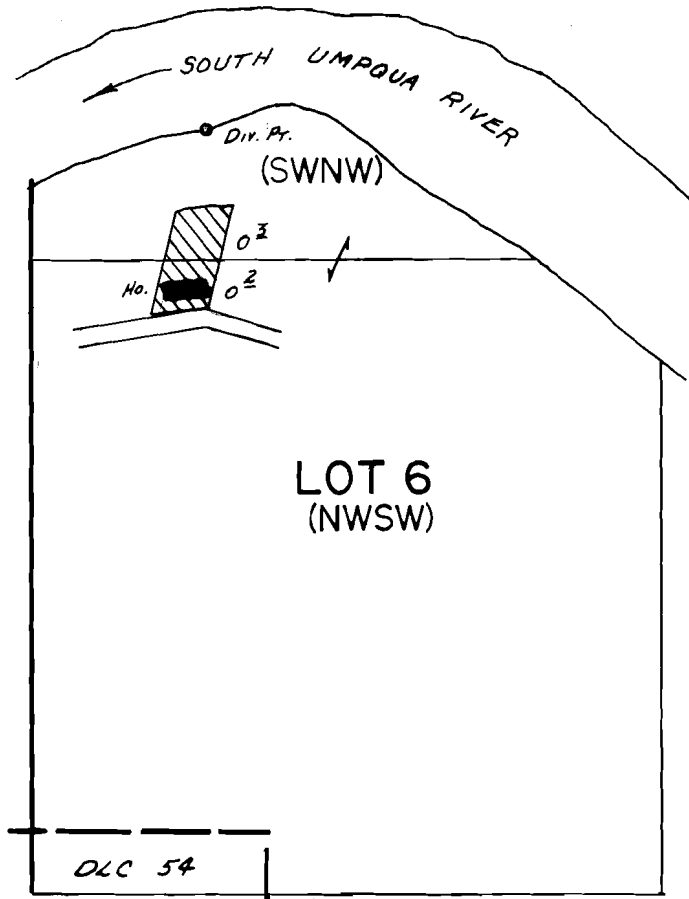

DIV. PT. LOC.: 220' N. & 360' E. FROM W 1/4 COR. SEC. 14

SCALE: 1" = 400'

FINAL PROOF SURVEY
UNDER

Application No. 56282 Permit No. 42382
IN NAME OF

THOMAS R. MURRAY

Surveyed MAR. 18. 1980. by J.S. DONALDSON