


T.26S. R.5W. W.M.

Sec. 14

S1/2 SW 1/4

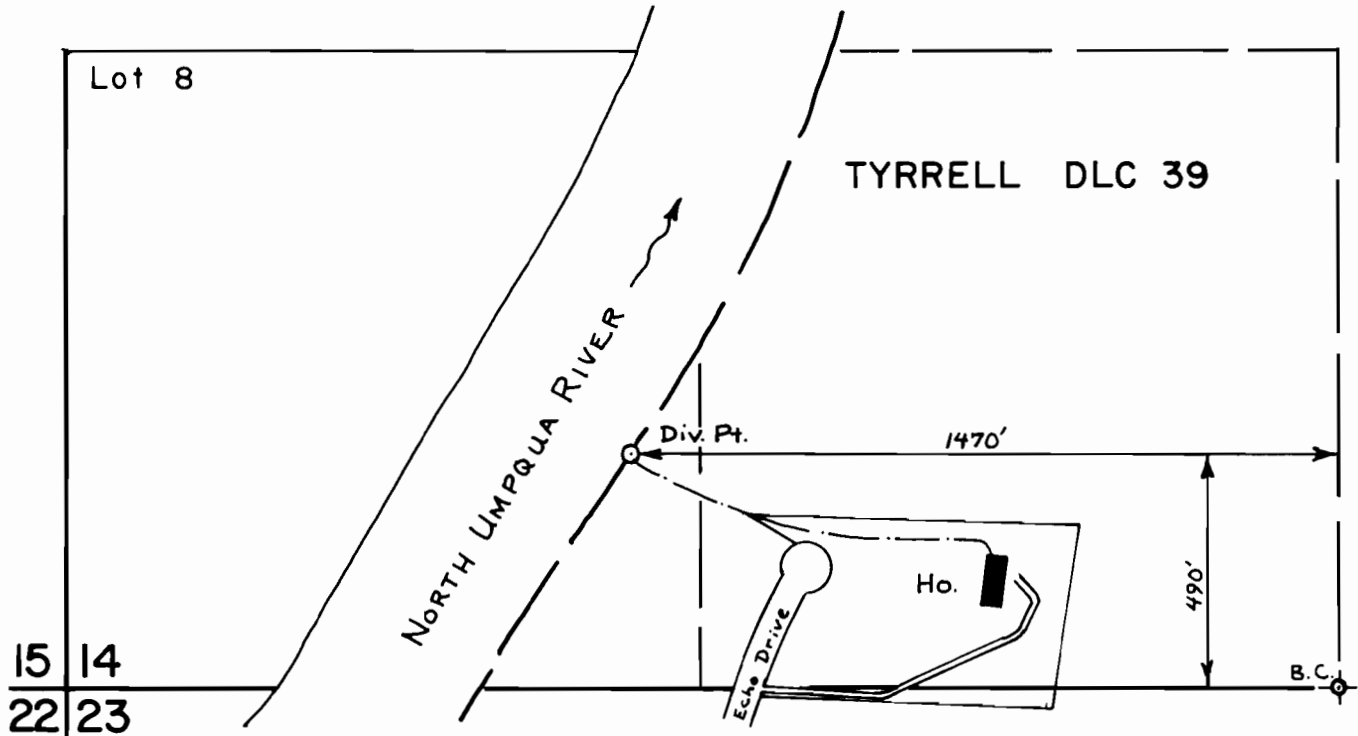

SCALE: 1" = 400'

ECHO BEND RANCH
Lot 39

FINAL PROOF SURVEY
UNDER

Application No. 57729 Permit No. 43546
IN NAME OF

M. ELAINE RICHMOND

Surveyed March 19, 1980, by S. Donaldson