


T.30S.,R.5W.,W.M.

SECTION 27

NE 1/4 NW 1/4

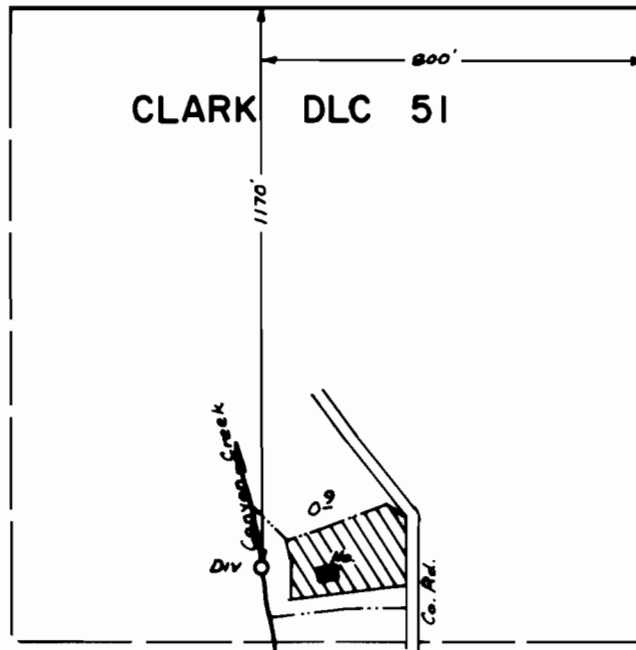

SCALE: 1" = 400'

FINAL PROOF SURVEY
UNDER

Application No. 58070... Permit No. 43749.....
IN NAME OF

.....PHYLLIS J. BREWER.....

Surveyed June..24.. 19.82., by L.M.TOLL.....