


T. 29 S., R. 5 W., W.M.

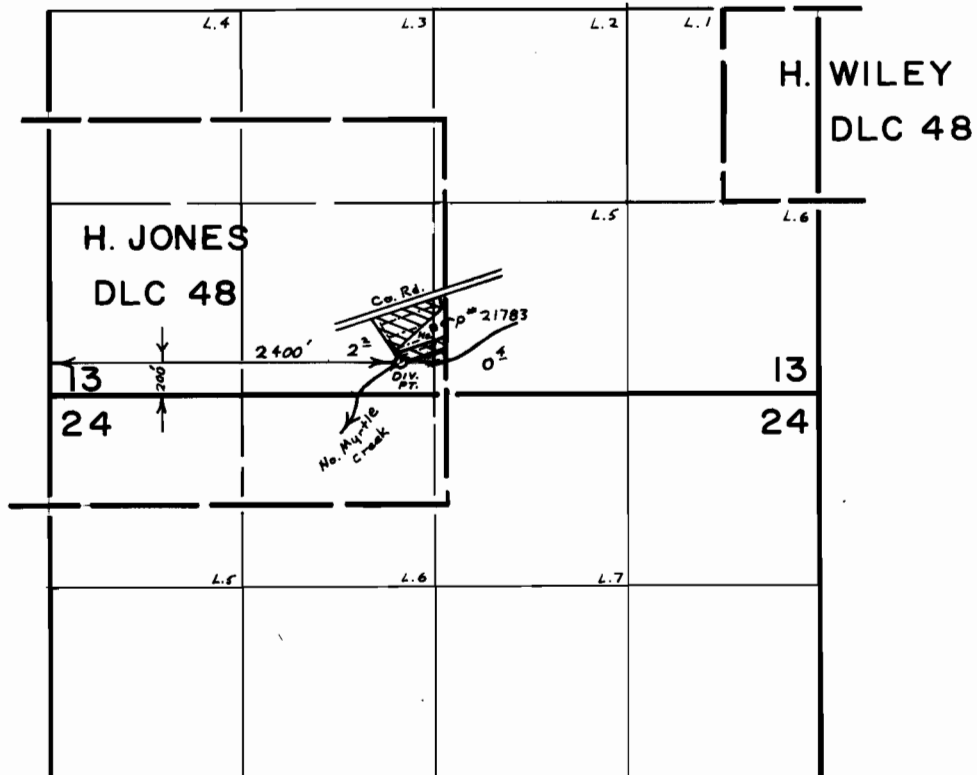

SCALE 4" = 1 mile

FINAL PROOF SURVEY UNDER

Application No. 58729 Permit No. 44296
IN NAME OF

.....EDWIN.....KUNTZ.....

Surveyed Dec. 12., 1979, by S. Donaldson