


T.27S.,R.4W.,W.M.

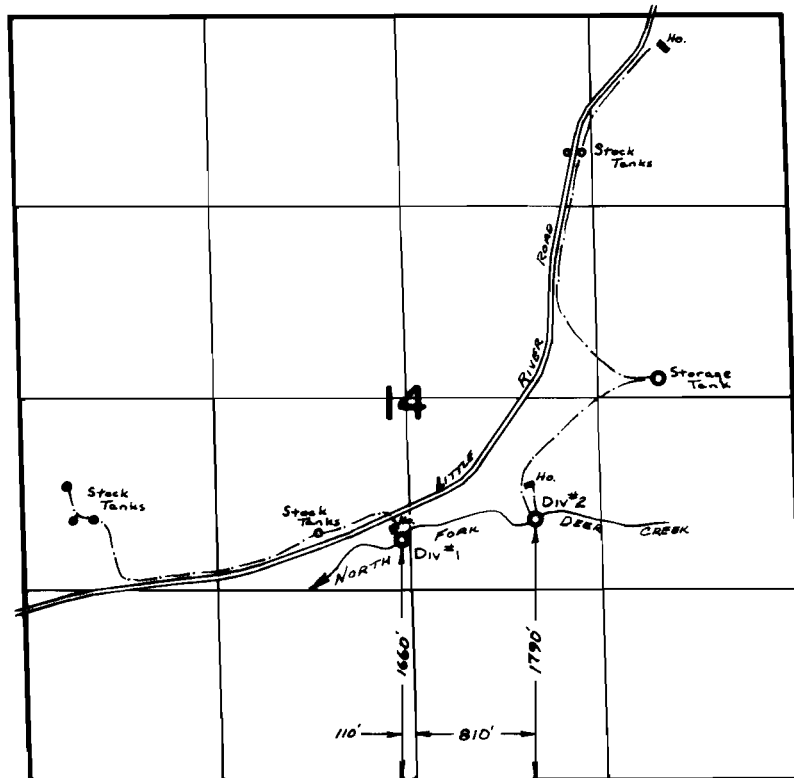

FINAL PROOF SURVEY
UNDER

Application No. 59189 Permit No. 44446
IN NAME OF

JUSTIN W. & RUTH EIFERT, SR.

Surveyed May 5, 1980, by J.S. DONALDSON.